City of Prince George
HISTORY SHEET

005261864
005261911

SHEET NUMBER **337** **Roll Number** 1152-000

Legal: LOT'S 11-12 BLOCK 55 D.L. 343 PLAN 1268

Address: WOOD STEPHEN M 370 BURDEN ST
WOOD VIRGINIA D PRINCE GEORGE, B.C. 370 BURDEN ST.

Sanitary Connection: # 639 SIZE 100mm MATERIAL TRANSITE INV. 1927.25 CONNECTED -

Water Connection # 2438 SIZE 3/4" MATERIAL Cu METER - CONNECTED -

Storm Connection: # - SIZE MATERIAL INV. CONNECTED -

Cash Receipt No's: WATER SANITARY 1493 STORM

CURB FROM PROPERTY LINE - PAVEMENT WIDTH -

B.C. HYDRO O.H. UNDERGROUND CONNECTION -

B.C. TELEPHONE O.H. UNDERGROUND CONNECTION -

INLAND GAS IN LANE

Information Sheets: -

Comments:
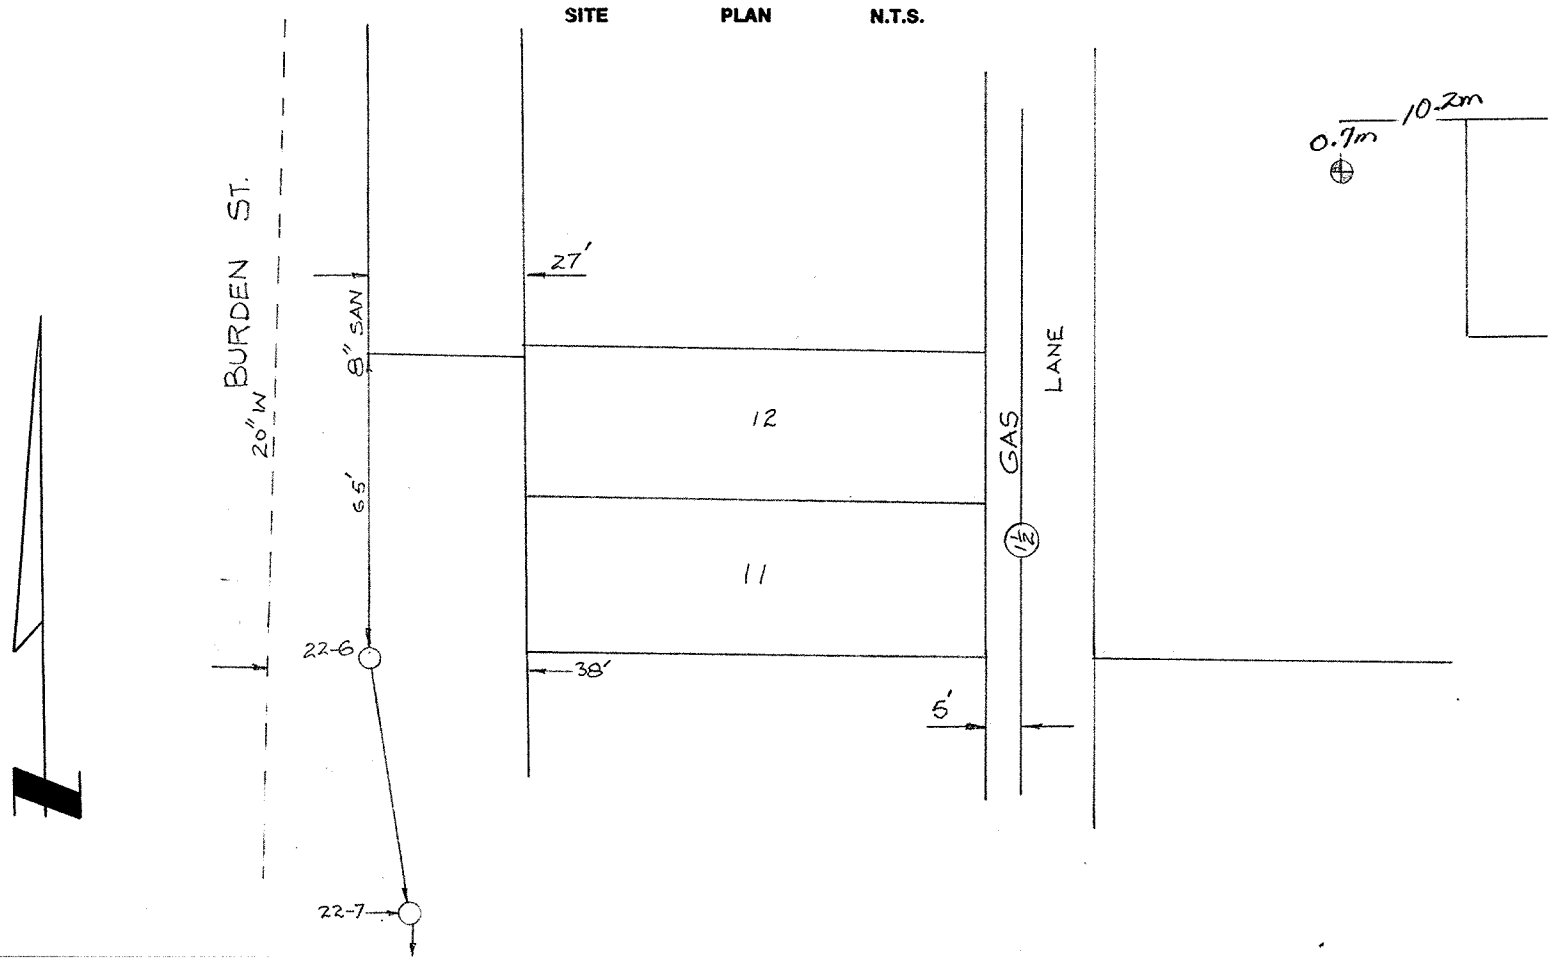
SITE PLAN N.T.S.