City of Prince George
HISTORY SHEET

SHEET NUMBER **1400** **Roll Number**

Legal: LOT'S 1-2-3 BLOCK 163 D.L. 343 PLAN 1268

Address: 1395 5th AVENUE

Sanitary Connection: # 543 SIZE 4" MATERIAL A.C. INV. - CONNECTED YES

Water Connection # 2193 SIZE - MATERIAL - METER - CONNECTED YES

Storm Connection: # 1466 SIZE 200mm MATERIAL PVC. INV. - CONNECTED -

Cash Receipt No's: WATER SANITARY STORM 0509

CURB FROM PROPERTY LINE 10' PAVEMENT WIDTH 60'

B.C. HYDRO O.H. UNDERGROUND CONNECTION

B.C. TELEPHONE UNDERGROUND CONNECTION IN LANE N' OF 6th AVE ALONG WEST SIDE OF BRUNSWICK

INLAND GAS IN LANE & 3" MAIN

Information Sheets: BENCH MARK # 24-68 ELEVATION = 1878.24

Comments: H.N. N.E. CORNER 5th AND BRUNSWICK

The information contained herein is for internal use only. Not to be relied upon unless confirmed by site inspection and/or investigation.
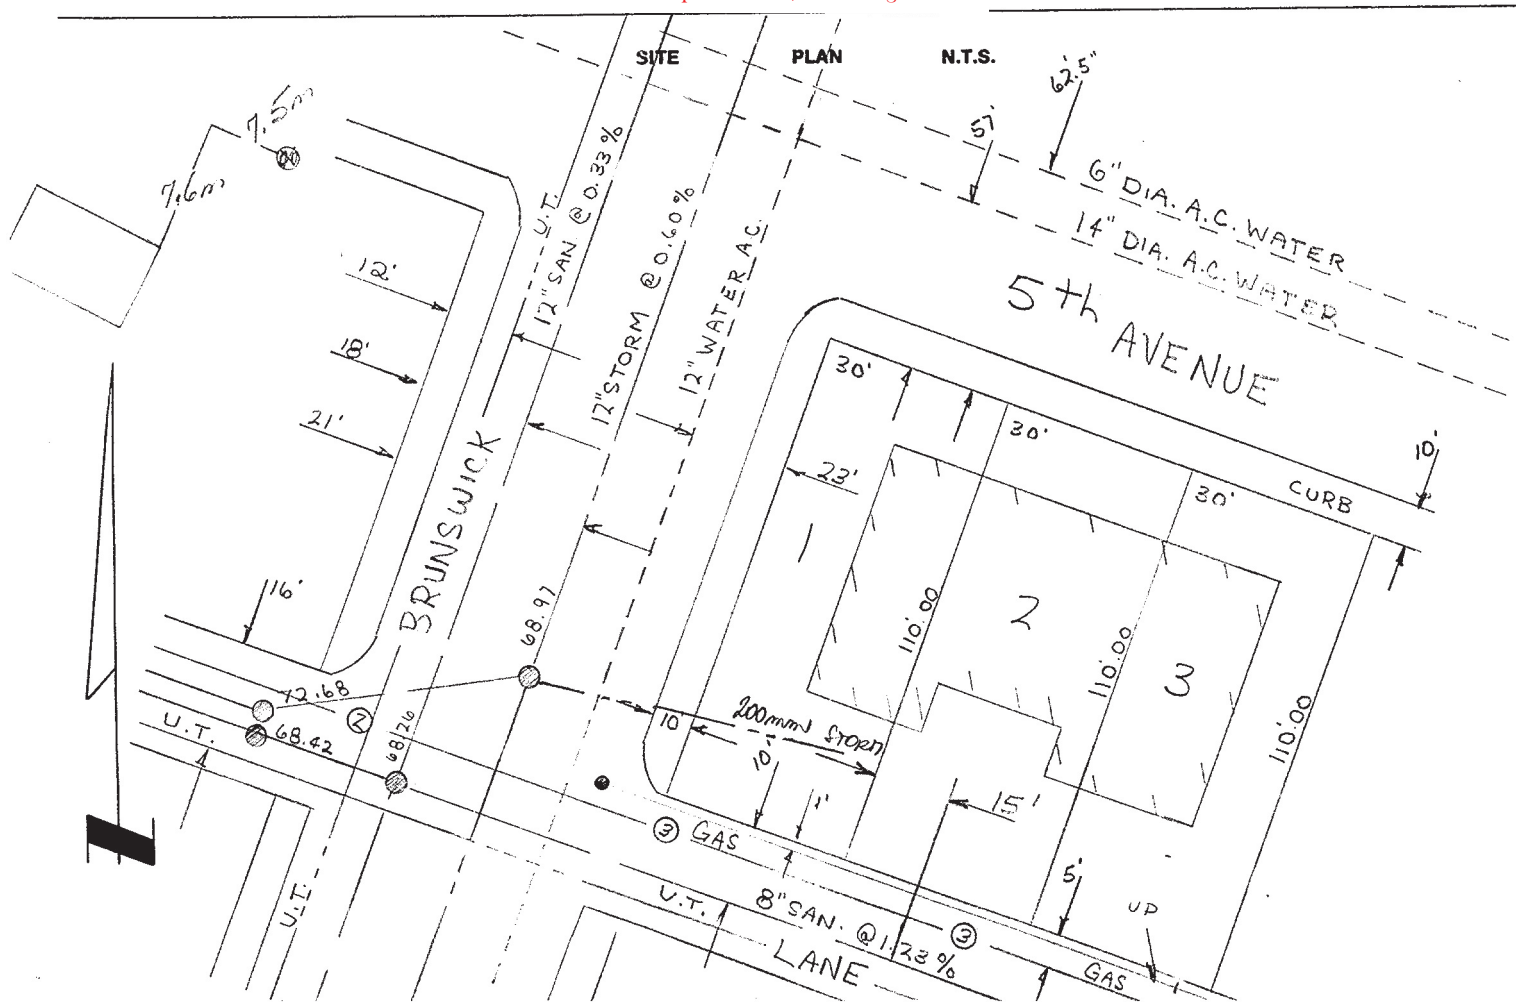
SITE PLAN N.T.S.