City of Prince George
HISTORY SHEET

005340527, 005340594
005340543, 005340683

SHEET NUMBER **231** **Roll Number** 00-00896-000-6

Legal: LOT'S 18, 17, 16, 15 BLOCK 43 D.L. 343 PLAN 1268

Address: G. ALINIS ALBERT EX. c/o 2425 TAYLOR CR. KELOWNA BC 1175 SECOND AVE.

Sanitary Connection: # 2122 2123 2124 2125 9545 SIZE 4" MATERIAL A.C. INV. CONNECTED

Water Connection # 9545 2602 SIZE 6" MATERIAL A.C. METER 153 CONNECTED

Storm Connection: # 495 SIZE 6" MATERIAL INV. CONNECTED

Cash Receipt No's: WATER SANITARY – 144 STORM

CURB FROM PROPERTY LINE PAVEMENT WIDTH 46'

B.C. HYDRO O.H UNDERGROUND CONNECTION –

B.C. TELEPHONE IN LANE UT-14. UNDERGROUND CONNECTION –

INLAND GAS IN LANE 3" ϕ MAIN.

Information Sheets: –

Comments: CONN # 2125 MAY BE FROM 2ND AVE.

CONN 2124 MAY BE FROM 2nd AVE
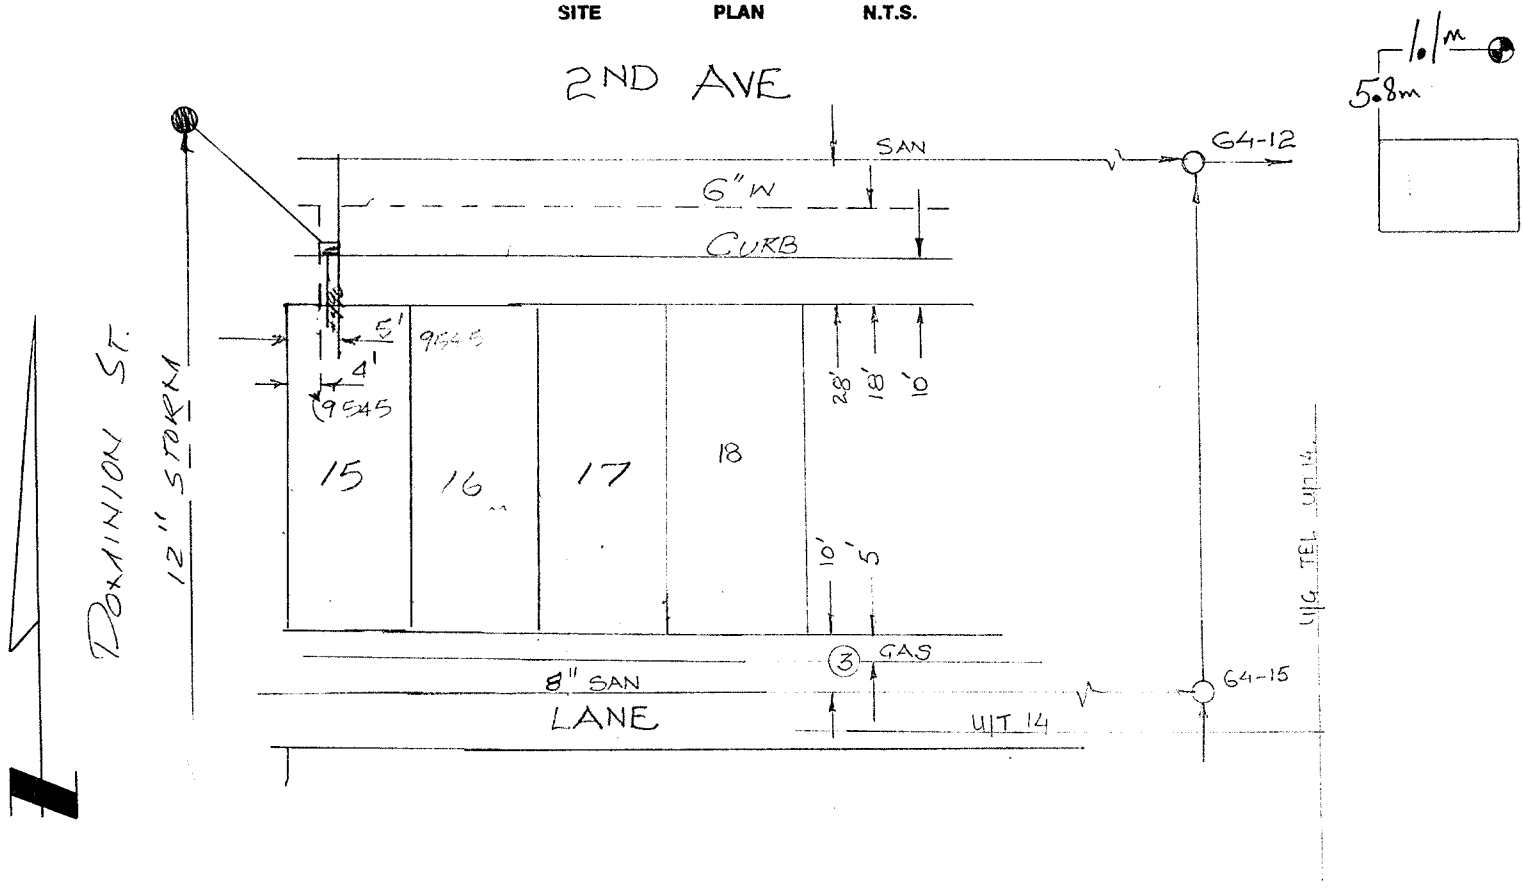
SITE PLAN N.T.S.