City of Prince George
HISTORY SHEET

SHEET NUMBER **Roll Number** 005346461

Legal: LOT'S 4 BLOCK D.L. 633 PLAN 23933

Address: WEST BITTNER RD.

Sanitary Connection: # 11480 SIZE 4" MATERIAL A.C. INV. CONNECTED

Water Connection # 11480 SIZE 3/4" MATERIAL CU. METER CONNECTED

Storm Connection: # SIZE MATERIAL INV. CONNECTED

Cash Receipt No's: WATER 0672 SANITARY 0673 STORM

CURB FROM PROPERTY LINE PAVEMENT WIDTH

B.C. HYDRO UNDERGROUND CONNECTION

B.C. TELEPHONE UNDERGROUND CONNECTION

INLAND GAS

Information Sheets:

Comments:
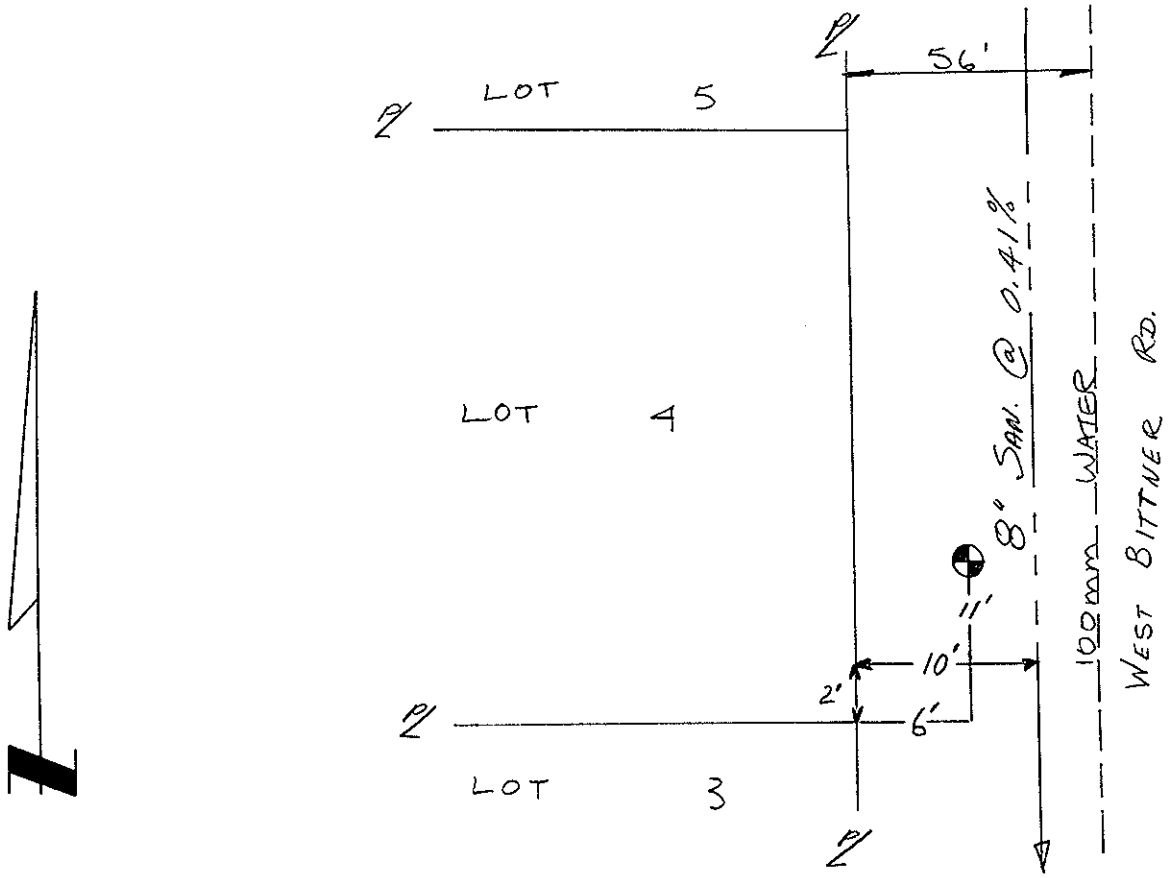
SITE PLAN N.T.S.