City of Prince George
HISTORY SHEET

SHEET NUMBER 5280 **Roll Number**

Legal: LOT'S 11 & 12 BLOCK 241 D.L. 343 PLAN 1268

Address: 1594 HEMLOCK ST.

Sanitary Connection: # 104 SIZE MATERIAL INV. 1888.89 CONNECTED

Water Connection # 386 SIZE ½" MATERIAL Cu METER CONNECTED

Storm Connection: # SIZE MATERIAL INV. CONNECTED

Cash Receipt No's: WATER SANITARY STORM

CURB FROM PROPERTY LINE PAVEMENT WIDTH

B.C. HYDRO O.H. UNDERGROUND CONNECTION

B.C. TELEPHONE O.H. UNDERGROUND CONNECTION

INLAND GAS AS SHOWN

Information Sheets:

Comments:
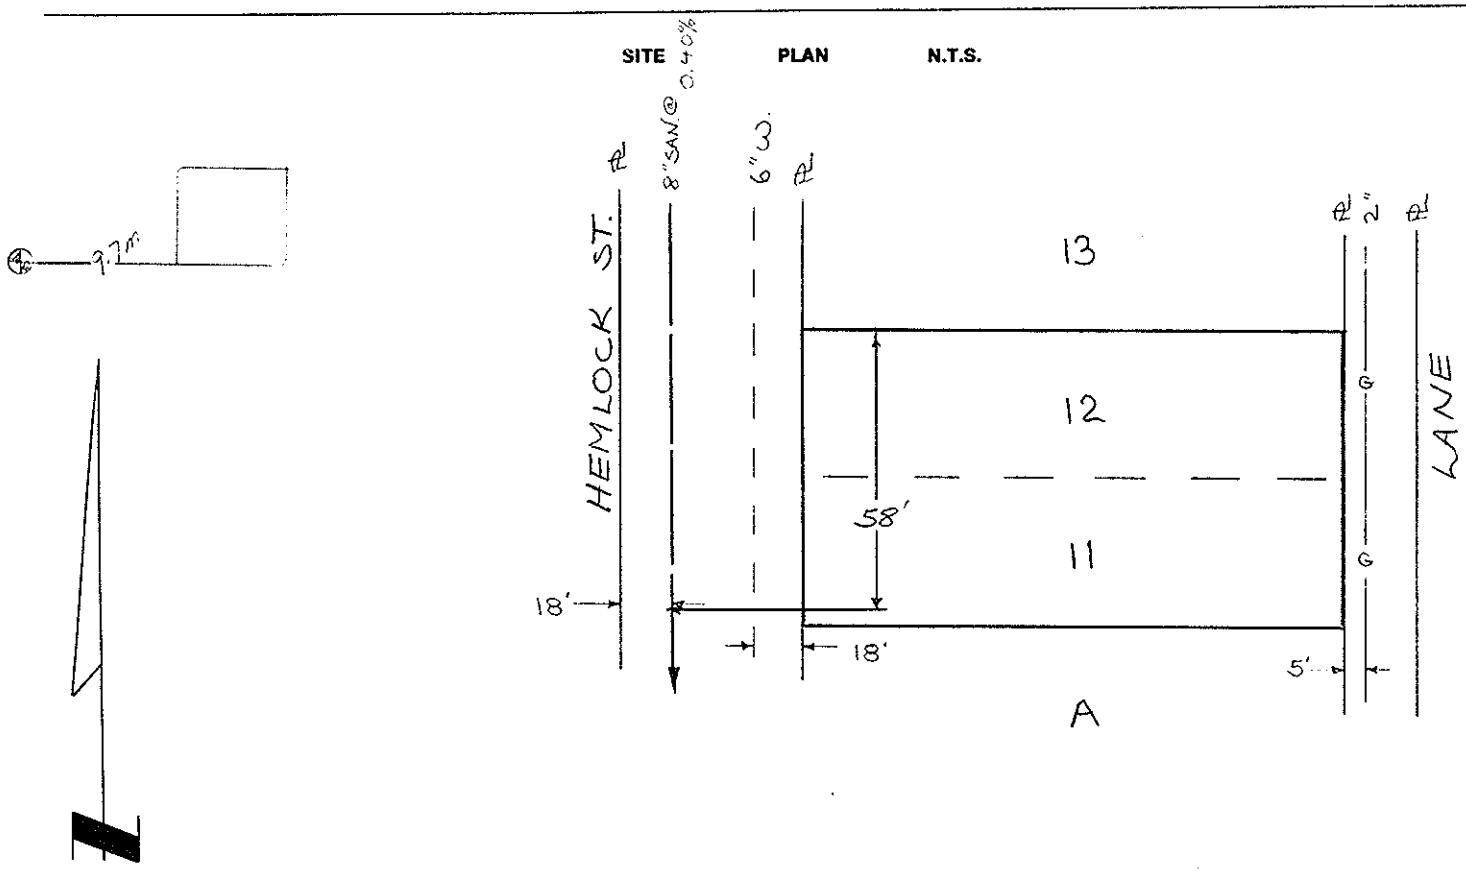
SITE PLAN N.T.S.