City of Prince George
HISTORY SHEET

PREPARED BY GDC

SHEET NUMBER № 4585 **Roll Number** 305 393 [illegible]

Legal: LOT'S 33 BLOCK D.L. 4050 PLAN 27403

Address: 4687 NEWGLEN PL

Sanitary Connection: # SIZE 100 mm MATERIAL P.V.C. INV. 602.38 CONNECTED

Water Connection # SIZE 20 mm MATERIAL Cu METER CONNECTED

Storm Connection: # SIZE MATERIAL INV. CONNECTED

Cash Receipt No's: WATER SANITARY STORM

CURB FROM PROPERTY LINE 5.0 m (ROLL CURB) PAVEMENT WIDTH 10.0 m

B.C. HYDRO UNDERGROUND CONNECTION U/G MID LOT

B.C. TELEPHONE UNDERGROUND CONNECTION U/G MID LOT

INLAND GAS 1.5 m OFFSET

Information Sheets:

Comments: BENCH MARK - ELEVATION 606.308
H.S. N.W. CORNER NEW GLEN PLACE &
NORTH MEADOWS ROAD

The information contained herein is for internal use only. Not to be relied upon unless confirmed by site inspection and/or investigation.
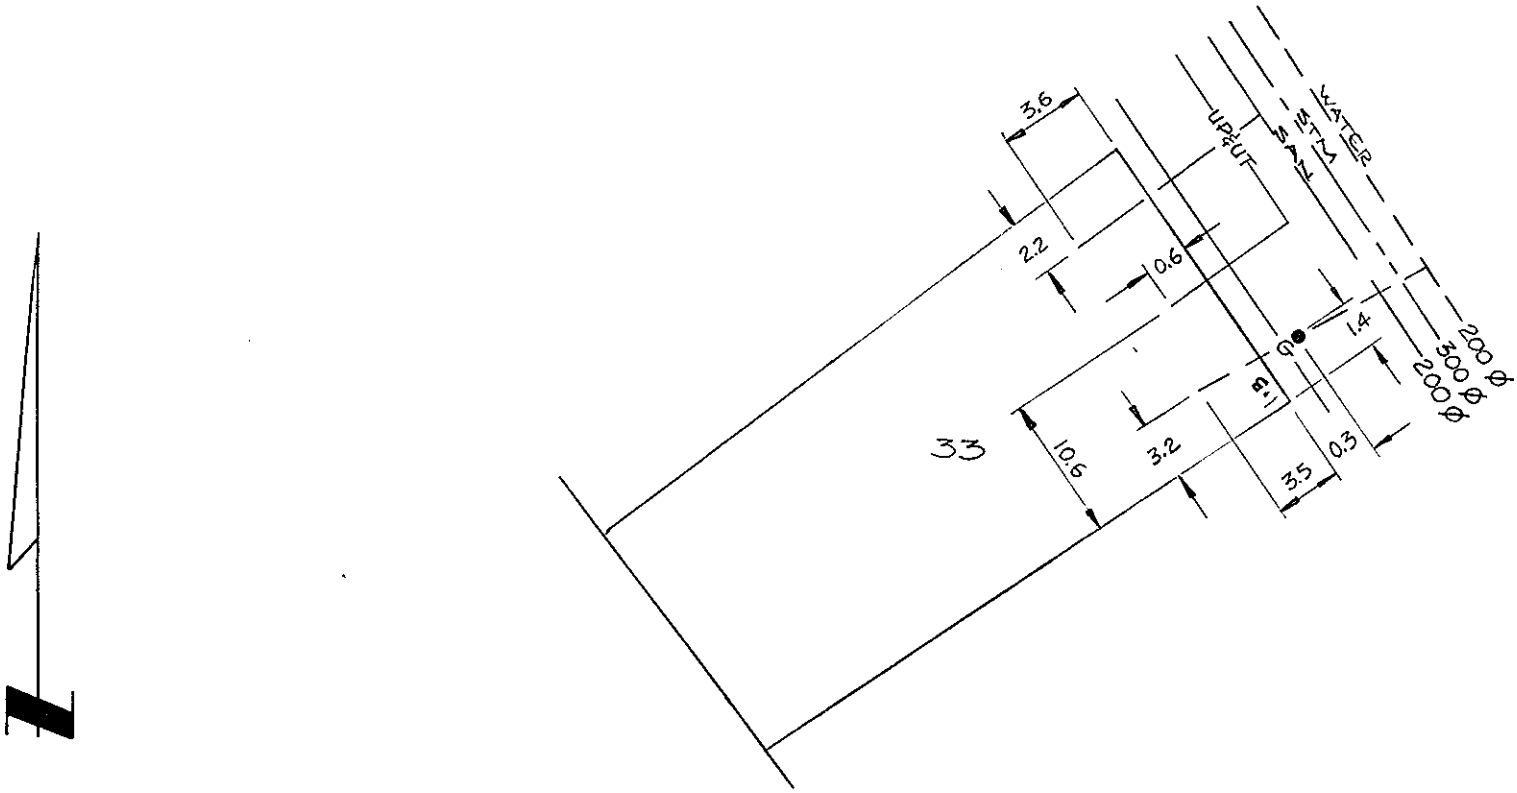
SITE PLAN N.T.S.