City of Prince George
HISTORY SHEET

005498252

SHEET NUMBER № 2703 **Roll Number**

Legal: LOT'S 89 BLOCK D.L. 905 PLAN 24848

Address: 2872 CALHOUN CRES.

Sanitary Connection: # 12788 SIZE 100mm MATERIAL INV. CONNECTED

Water Connection # 12788 SIZE 19mm MATERIAL METER CONNECTED

Storm Connection: # 1264 SIZE 100mm MATERIAL INV. CONNECTED

Cash Receipt No's: WATER SANITARY STORM

CURB FROM PROPERTY LINE PAVEMENT WIDTH

B.C. HYDRO UNDERGROUND CONNECTION

B.C. TELEPHONE UNDERGROUND CONNECTION

INLAND GAS

Information Sheets:

Comments:
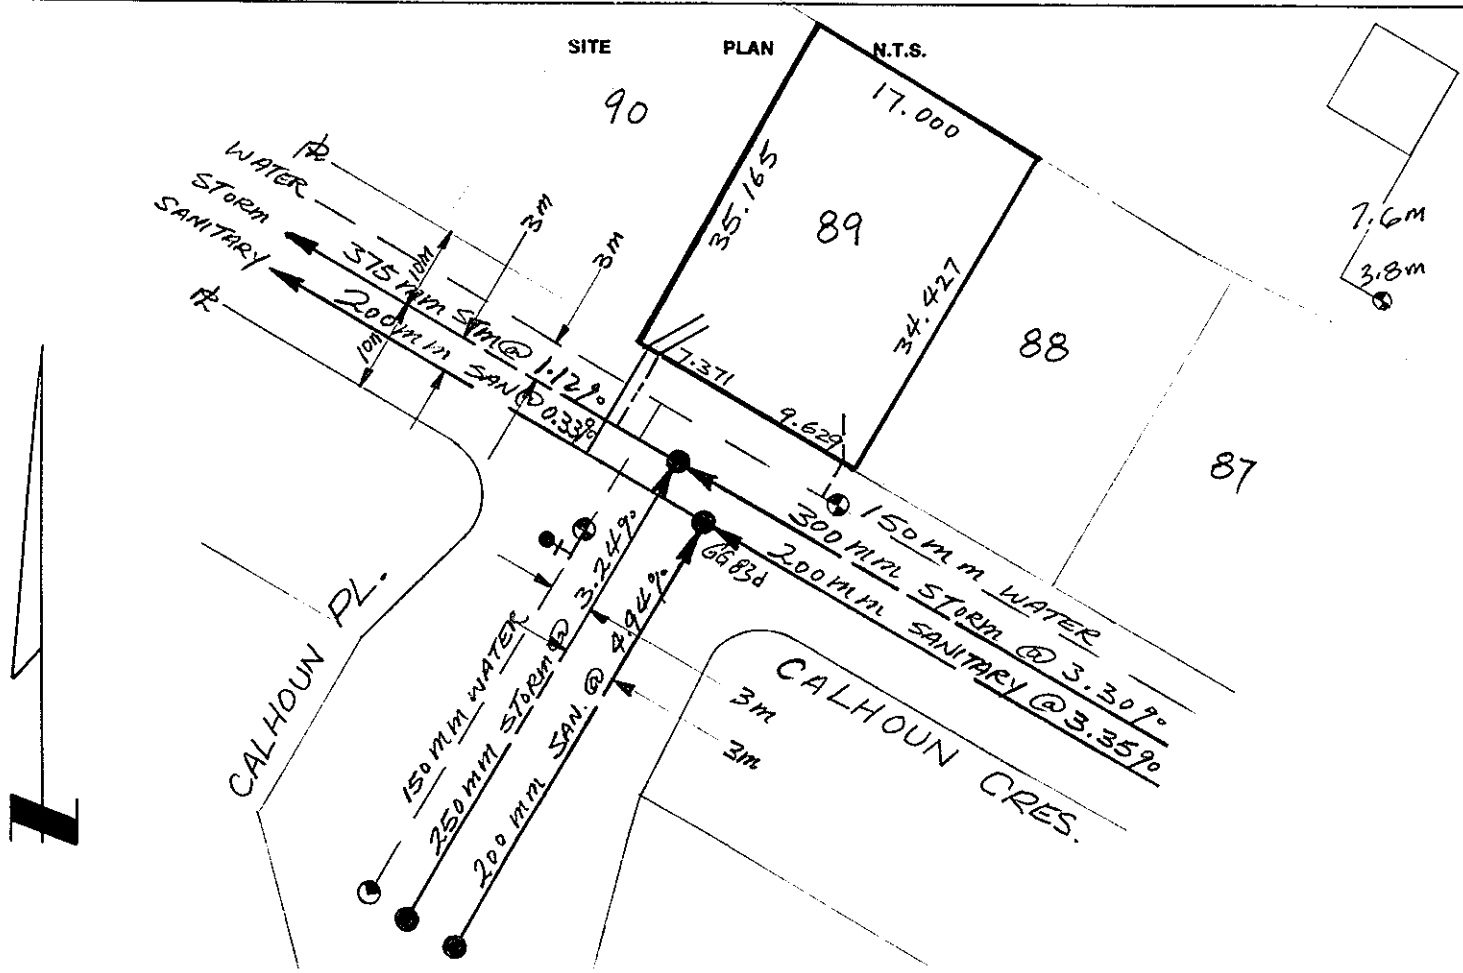
SITE PLAN N.T.S.