City of Prince George
HISTORY SHEET

SHEET NUMBER 11686 **Roll Number** 005505861

Legal: LOT'S 32 BLOCK D.L. 7634 PLAN 16573

Address: 4/6 6 CHURCHILL RD.

Sanitary Connection: # SIZE 100mm MATERIAL P.V.C. INV. CONNECTED

Water Connection # SIZE 20mm MATERIAL Cu METER CONNECTED

Storm Connection: # SIZE MATERIAL INV. CONNECTED

Cash Receipt No's: WATER SANITARY STORM

CURB FROM PROPERTY LINE PAVEMENT WIDTH 10.00 m

B.C. HYDRO O/H UNDERGROUND CONNECTION

B.C. TELEPHONE O/H UNDERGROUND CONNECTION

INLAND GAS AS SHOWN

Information Sheets:

Comments: ELEV. ± 3m @ P.L., WATER SERVICE ON LOT 31
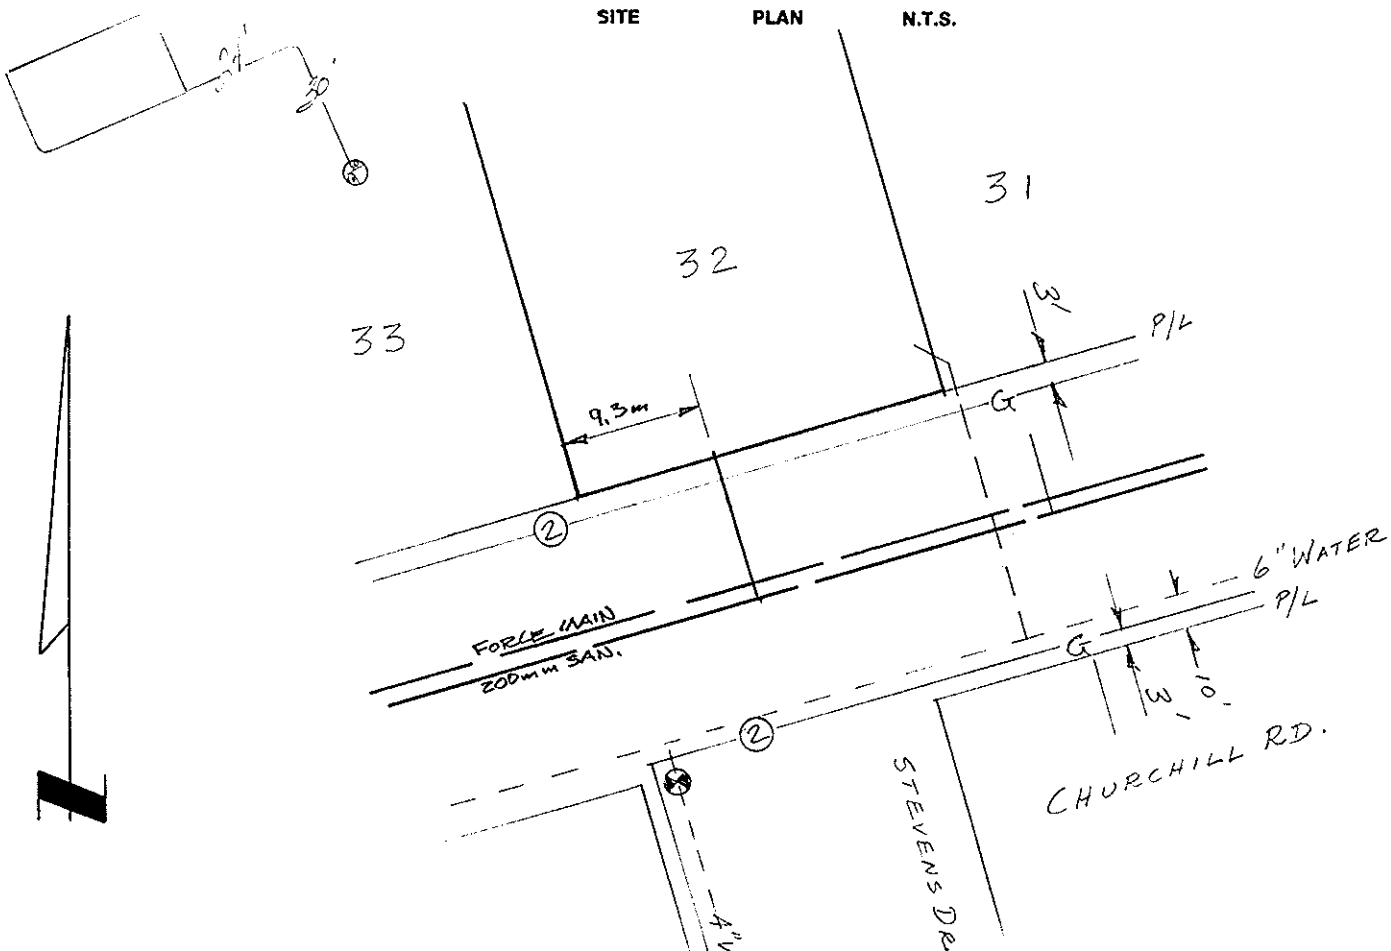
SITE PLAN N.T.S.