City of Prince George
HISTORY SHEET

SHEET NUMBER № 2229 **Roll Number** 005544203

Legal: LOT'S A BLOCK D.L. 261b PLAN 30007

Address: 777 KINSMAN PL.

Sanitary Connection: # 16416 / 15112 SIZE 100mm MATERIAL PVC INV. CONNECTED

Water Connection # 15112 SIZE 40mm MATERIAL Copper METER CONNECTED

Storm Connection: # 1399 SIZE 200mm MATERIAL PVC INV. CONNECTED

Cash Receipt No's: WATER SANITARY 16416 - 0856 STORM

CURB FROM PROPERTY LINE PAVEMENT WIDTH

B.C. HYDRO UNDERGROUND CONNECTION

B.C. TELEPHONE UNDERGROUND CONNECTION

INLAND GAS

Information Sheets:

Comments:
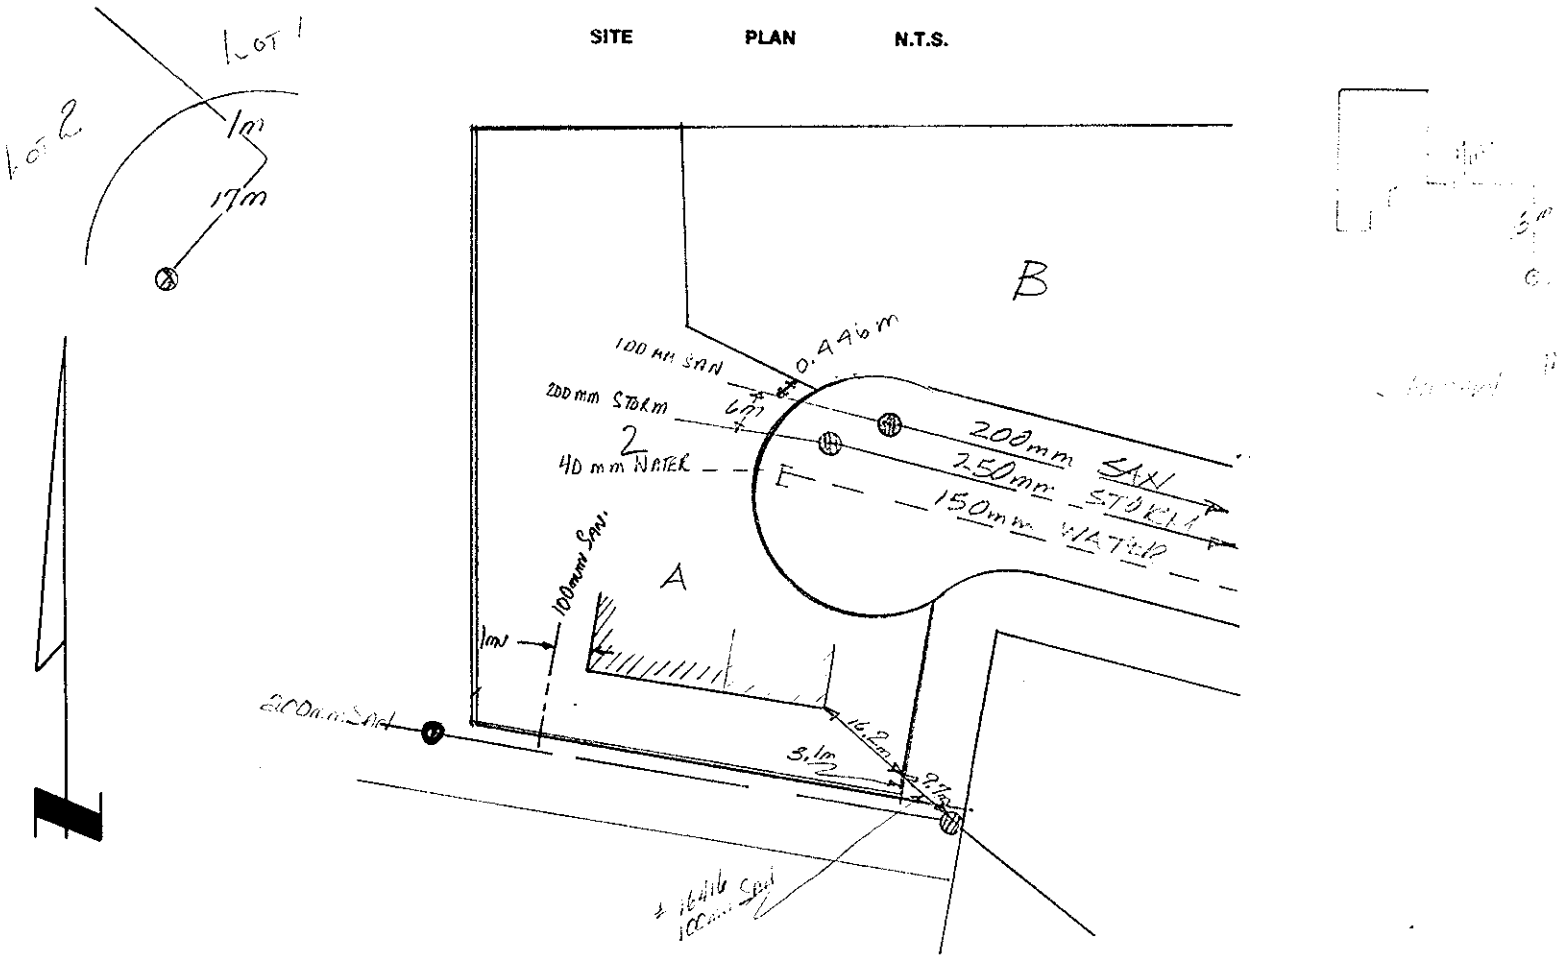
SITE PLAN N.T.S.