City of Prince George
HISTORY SHEET

SHEET NUMBER № 3250 **Roll Number** 0055666606

Legal: LOT'S 20 BLOCK D.L. 745 PLAN 29700

Address: 4834 CONTINENTAL WAY

Sanitary Connection: # SIZE 100mm MATERIAL P.V.C. INV. 593.99 CONNECTED

Water Connection # SIZE 25mm MATERIAL COPPER METER CONNECTED

Storm Connection: # SIZE 150mm MATERIAL P.V.C. INV. 594.36 CONNECTED

Cash Receipt No's: WATER SANITARY STORM

CURB FROM PROPERTY LINE 3.5m ROLL CURB PAVEMENT WIDTH 13.0m

B.C. HYDRO UNDERGROUND CONNECTION

B.C. TELEPHONE UNDERGROUND CONNECTION

INLAND GAS

Information Sheets:

Comments: CITY B.M. # 774-73 H.N. WEST SIDE OF PACIFIC ℄ SOUTH OF TERMINAL EL 595.364

THE INFORMATION CONTAINED HEREIN IS FOR INTERNAL USE ONLY. NOT TO BE RELIED UPON UNLESS CONFIRMED BY SITE INSPECTION AND/OR INVESTIGATION.
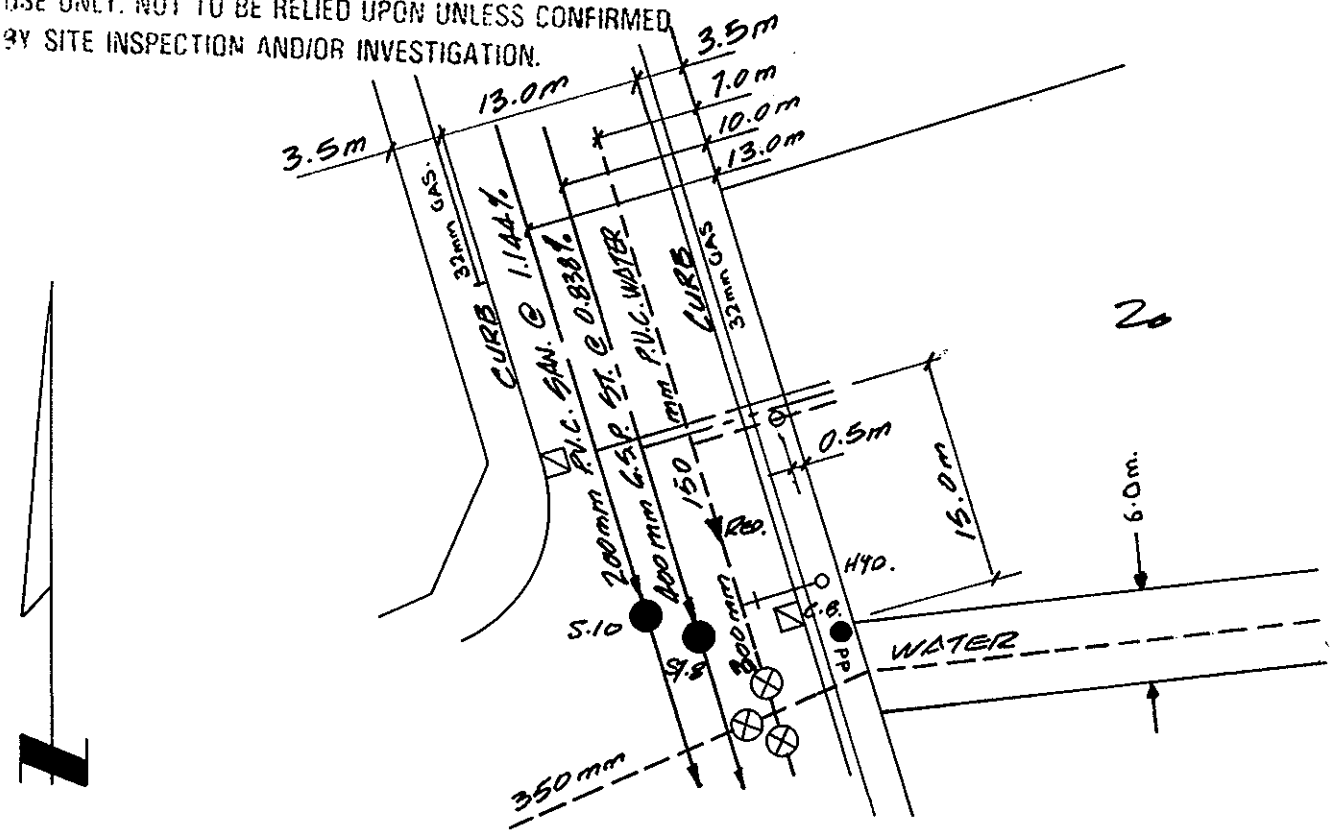
SITE PLAN N.T.S.