00557099 S

City of Prince George
HISTORY SHEET

(1D)

SHEET NUMBER 24 Roll Number 00556 9991 182-000

Legal: LOT'S 17-18 BLOCK 10 D.L. 343 PLAN 1268

Address: LEE JACK PRINCE GEORGE, B.C. 190-198 FORT ST.

Sanitary Connection: # - SIZE - MATERIAL INV. CONNECTED -

Water Connection # - SIZE - MATERIAL METER CONNECTED -

Storm Connection: # - SIZE MATERIAL INV. CONNECTED -

Cash Receipt No's: WATER SANITARY STORM

CURB FROM PROPERTY LINE 10' (1ST AVE) PAVEMENT WIDTH 54'

B.C. HYDRO O.H. UNDERGROUND CONNECTION -

B.C. TELEPHONE O.H. UNDERGROUND CONNECTION -

INLAND GAS ON 1ST AVE 6" ϕ MAIN.

Information Sheets: -

Comments:
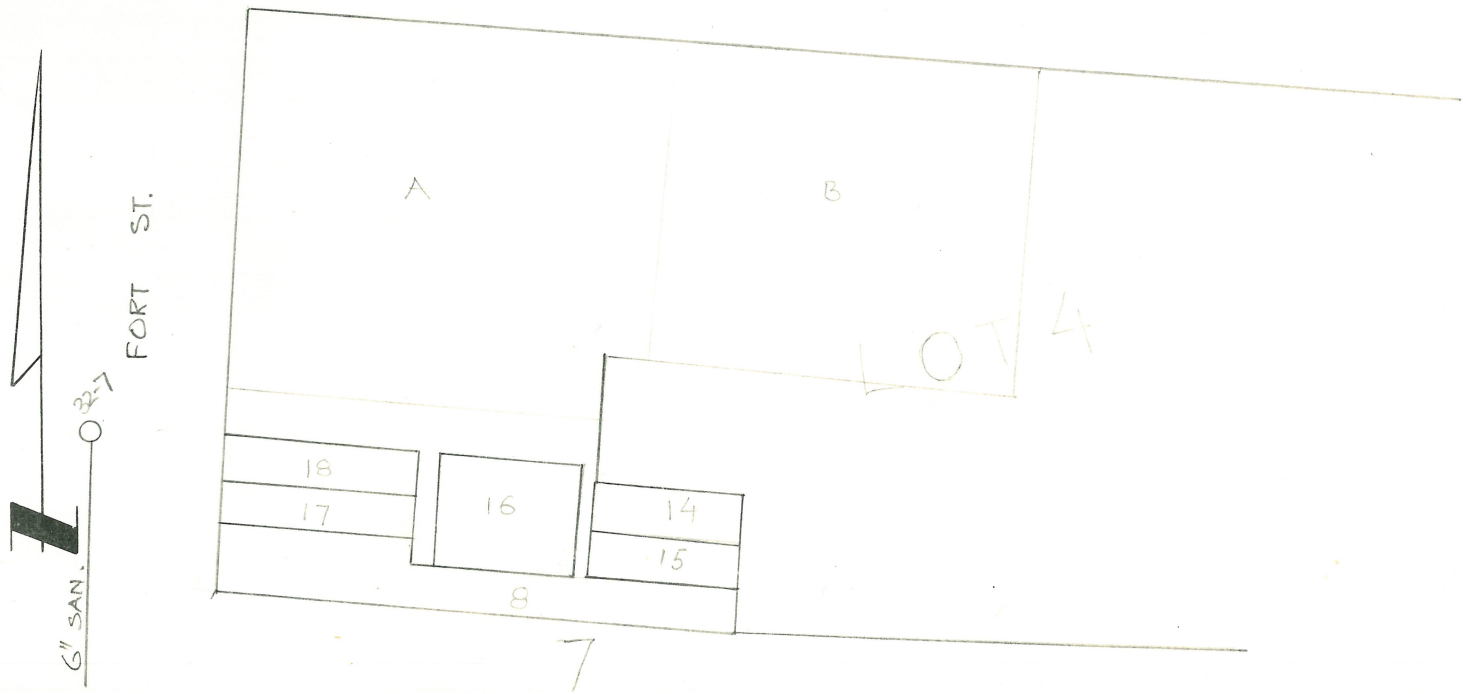
SITE PLAN N.T.S.