City of Prince George
HISTORY SHEET

SHEET NUMBER **Roll Number** 005658.003

Legal: LOT'S 12 BLOCK D.L. 4048 PLAN 29328

Address: 4733 VELLENCHER RD

Sanitary Connection: # SIZE 100mm MATERIAL INV. 790.849 CONNECTED

Water Connection # SIZE 20mm MATERIAL METER CONNECTED

Storm Connection: # SIZE MATERIAL INV. CONNECTED

Cash Receipt No's: WATER SANITARY STORM

CURB FROM PROPERTY LINE PAVEMENT WIDTH

B.C. HYDRO UNDERGROUND CONNECTION

B.C. TELEPHONE UNDERGROUND CONNECTION

INLAND GAS

Information Sheets:

Comments: WATER AND SANITARY CONNECTIONS ARE COMMON TRENCHED
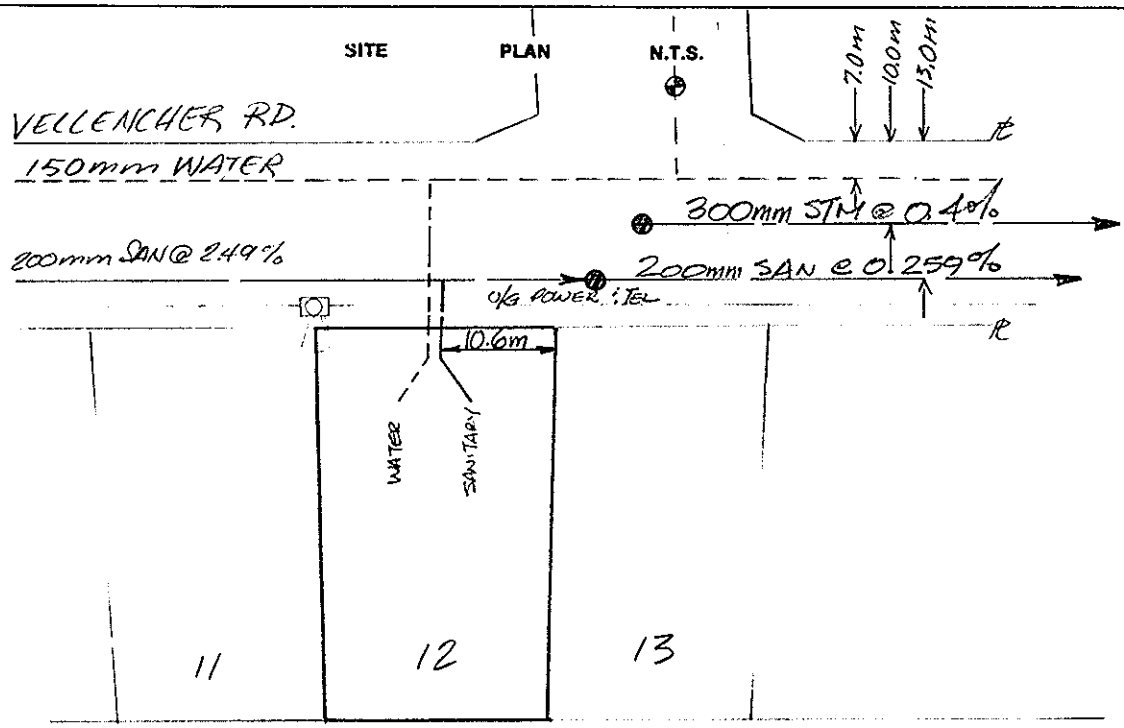
SITE PLAN N.T.S.