00572025?
00572024?
00572023?
00572023?

City of Prince George
HISTORY SHEET

SHEET NUMBER **63** **Roll Number** 404-000

Legal: LOT'S 20-23 BLOCK 20 D.L. 343 PLAN 1268

Address: SOUTHAM PRESS LIMITED BOX 578 PRINCE GEORGE, B.C. (150 BRUNSWICK ST.)

Sanitary Connection: # 3742 SIZE MATERIAL INV. 1870.25 CONNECTED YES

Water Connection # 11332 3459 SIZE 6" 2" MATERIAL Cu METER #90 CONNECTED YES

Storm Connection: # — SIZE MATERIAL INV. CONNECTED —

Cash Receipt No's: WATER — 1668 SANITARY 1650 STORM

CURB FROM PROPERTY LINE 1' PAVEMENT WIDTH 46'

B.C. HYDRO O.H. UNDERGROUND CONNECTION —

B.C. TELEPHONE O.H. UNDERGROUND CONNECTION —

INLAND GAS ON LANE 2" Φ MAIN.

Information Sheets: 199

Comments:
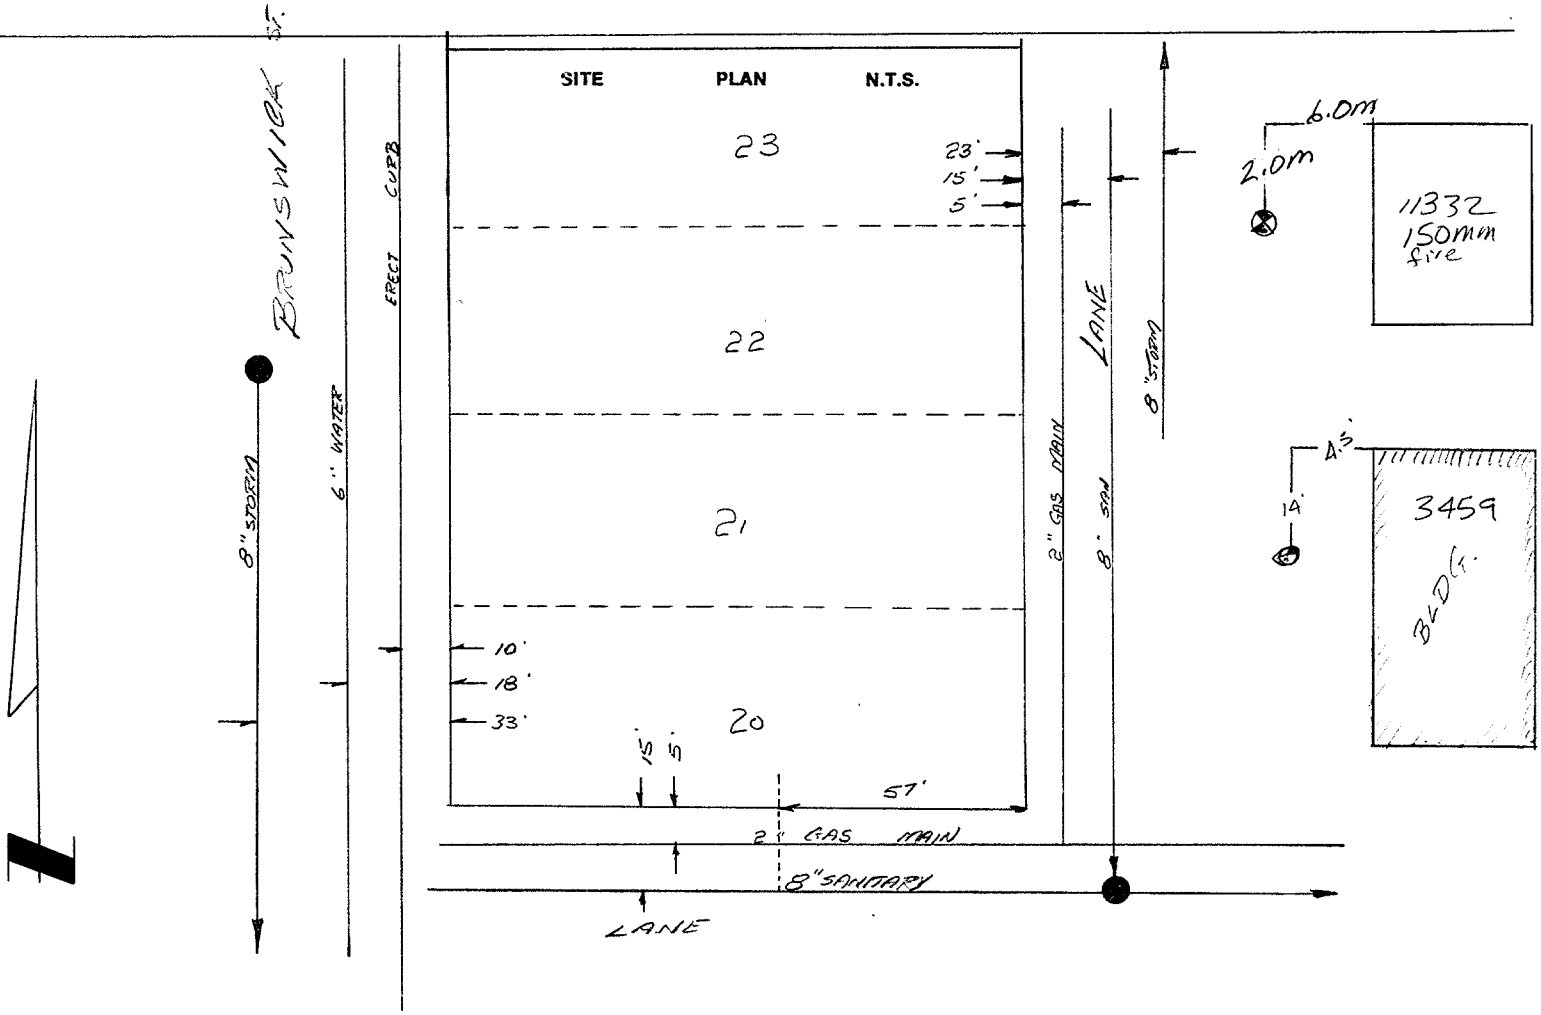
The information contained herein is for internal use only. Not to be relied upon unless confirmed by site inspection and/or investigation.