City of Prince George
HISTORY SHEET

005750652

SHEET NUMBER № 1058 **Roll Number** 679

Legal: LOT'S 19-20 BLOCK 32 D.L. 1429 PLAN 646

Address: 1164 HARPER ST.

Sanitary Connection: # 1416 SIZE 100 mm MATERIAL INV. CONNECTED

Water Connection # 1545 SIZE 19 mm MATERIAL COPPER METER CONNECTED

Storm Connection: # SIZE MATERIAL INV. CONNECTED

Cash Receipt No's: WATER SANITARY STORM

CURB FROM PROPERTY LINE PAVEMENT WIDTH

B.C. HYDRO UNDERGROUND CONNECTION

B.C. TELEPHONE UNDERGROUND CONNECTION

INLAND GAS

Information Sheets:

Comments:
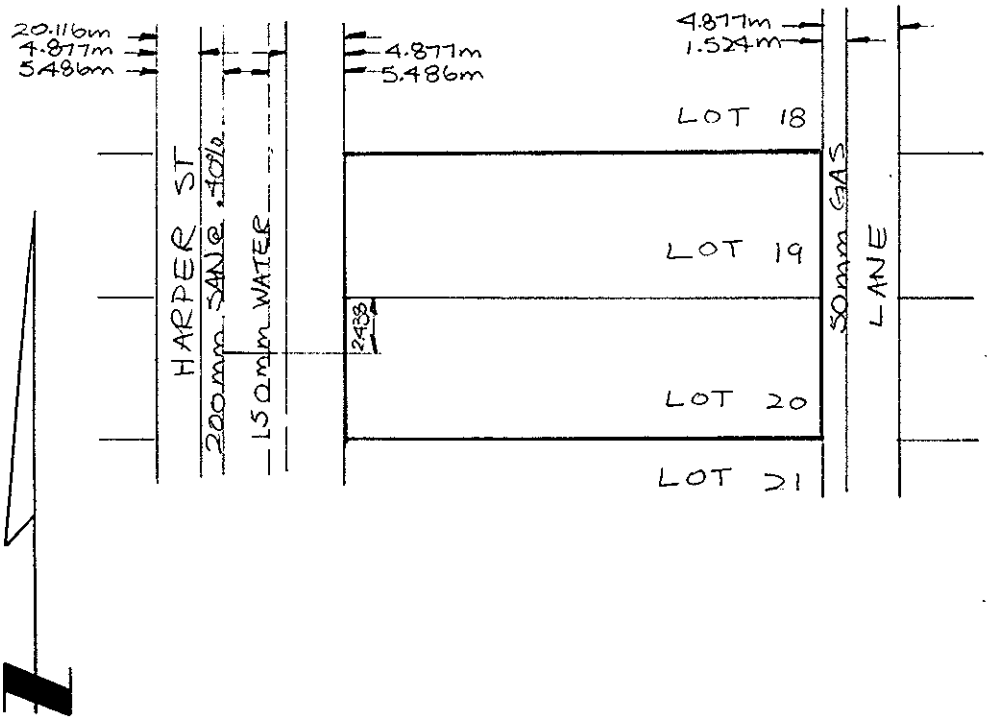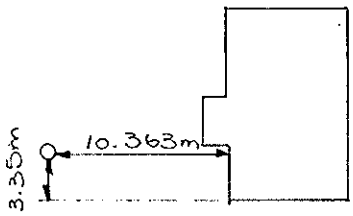
SITE PLAN N.T.S.