City of Prince George
HISTORY SHEET

005 808 804 ±

SHEET NUMBER **Roll Number**

Legal: LOT'S 8 BLOCK D.L. 4040 PLAN 29022

Address: 4016 [illegible] Pl

Sanitary Connection: # SIZE 50 mm MATERIAL INV. CONNECTED

Water Connection # SIZE 20 mm MATERIAL METER CONNECTED

Storm Connection: # SIZE MATERIAL INV. CONNECTED

Cash Receipt No's: WATER SANITARY STORM

CURB FROM PROPERTY LINE PAVEMENT WIDTH

B.C. HYDRO UNDERGROUND CONNECTION

B.C. TELEPHONE UNDERGROUND CONNECTION

INLAND GAS

Information Sheets:

Comments:

THE INFORMATION CONTAINED HEREIN IS FOR INTERNAL USE ONLY. NOT TO BE RELIED UPON UNLESS CONFIRMED BY SITE INSPECTION AND/OR INVESTIGATION.
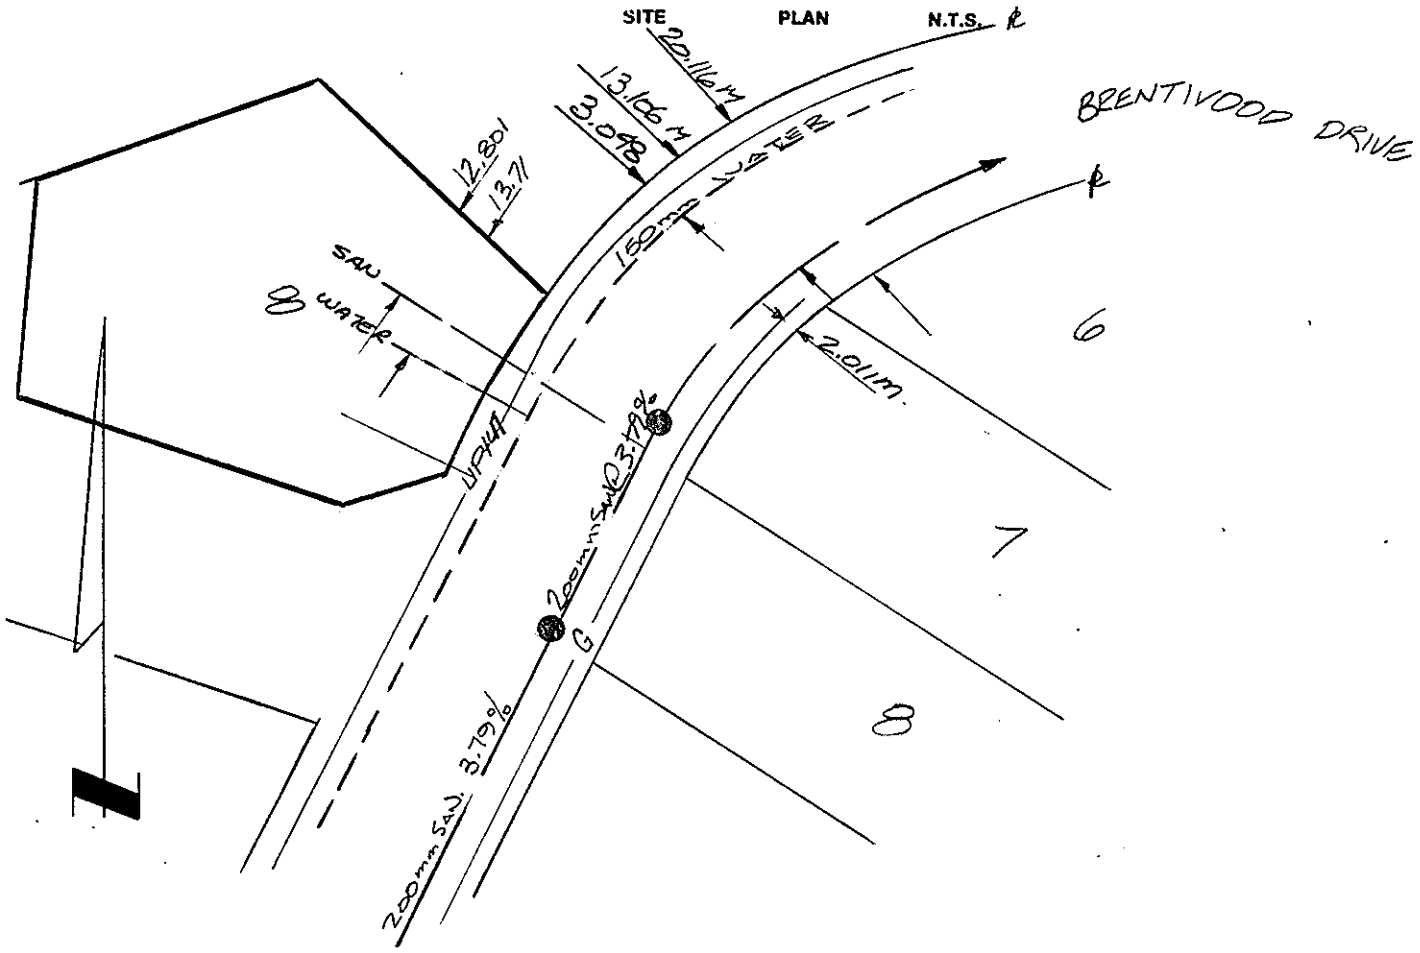
SITE PLAN N.T.S.