City of Prince George
HISTORY SHEET

SHEET NUMBER № 3406 **Roll Number** 005866243

Legal: LOT'S 1 BLOCK D.L. 954 PLAN 28856

Address: 1344 FOREMAN Rd.

Sanitary Connection: # SIZE 100mm MATERIAL INV. CONNECTED

Water Connection # SIZE 20mm MATERIAL METER CONNECTED

Storm Connection: # SIZE MATERIAL INV. CONNECTED

Cash Receipt No's: WATER SANITARY STORM

CURB FROM PROPERTY LINE PAVEMENT WIDTH

B.C. HYDRO OVERHEAD UNDERGROUND CONNECTION

B.C. TELEPHONE OVERHEAD UNDERGROUND CONNECTION

INLAND GAS NO GAS

Information Sheets:

Comments:
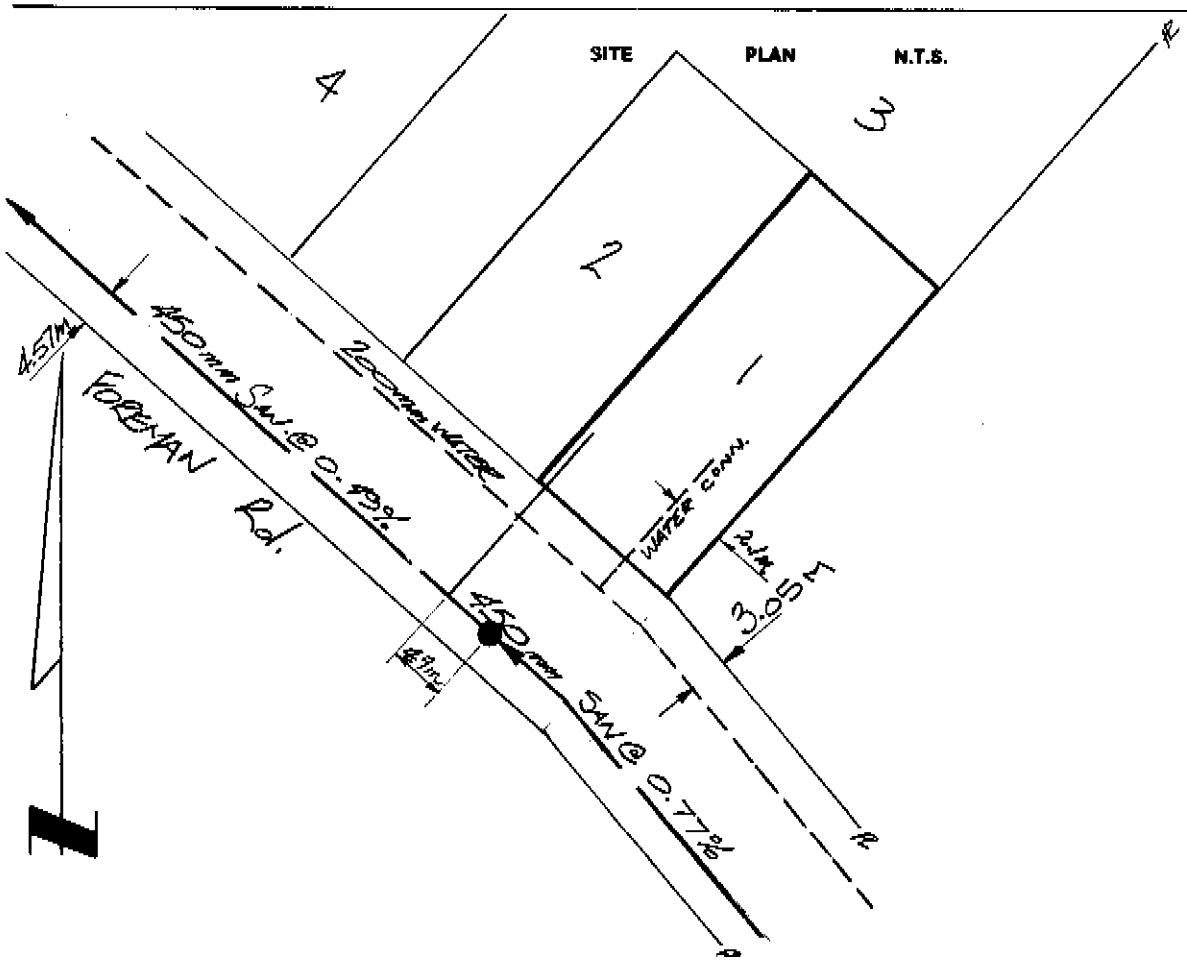
SITE PLAN N.T.S.