City of Prince George
HISTORY SHEET

5

SHEET NUMBER № 0666 **Roll Number** 0060235 33

Legal: LOT'S 34 BLOCK D.L. 2610 PLAN 21450

Address: 283 EXPLORER CRES

Sanitary Connection: # 9033 SIZE 100mm MATERIAL A.C. INV. CONNECTED

Water Connection # SIZE 50mm MATERIAL Cu. METER CONNECTED

Storm Connection: # SIZE MATERIAL INV. CONNECTED

Cash Receipt No's: WATER SANITARY STORM

CURB FROM PROPERTY LINE 4.877m PAVEMENT WIDTH 10.363m

B.C. HYDRO UNDERGROUND UNDERGROUND CONNECTION Yes

B.C. TELEPHONE UNDERGROUND UNDERGROUND CONNECTION Yes

INLAND GAS AS SHOWN

Information Sheets:

Comments:
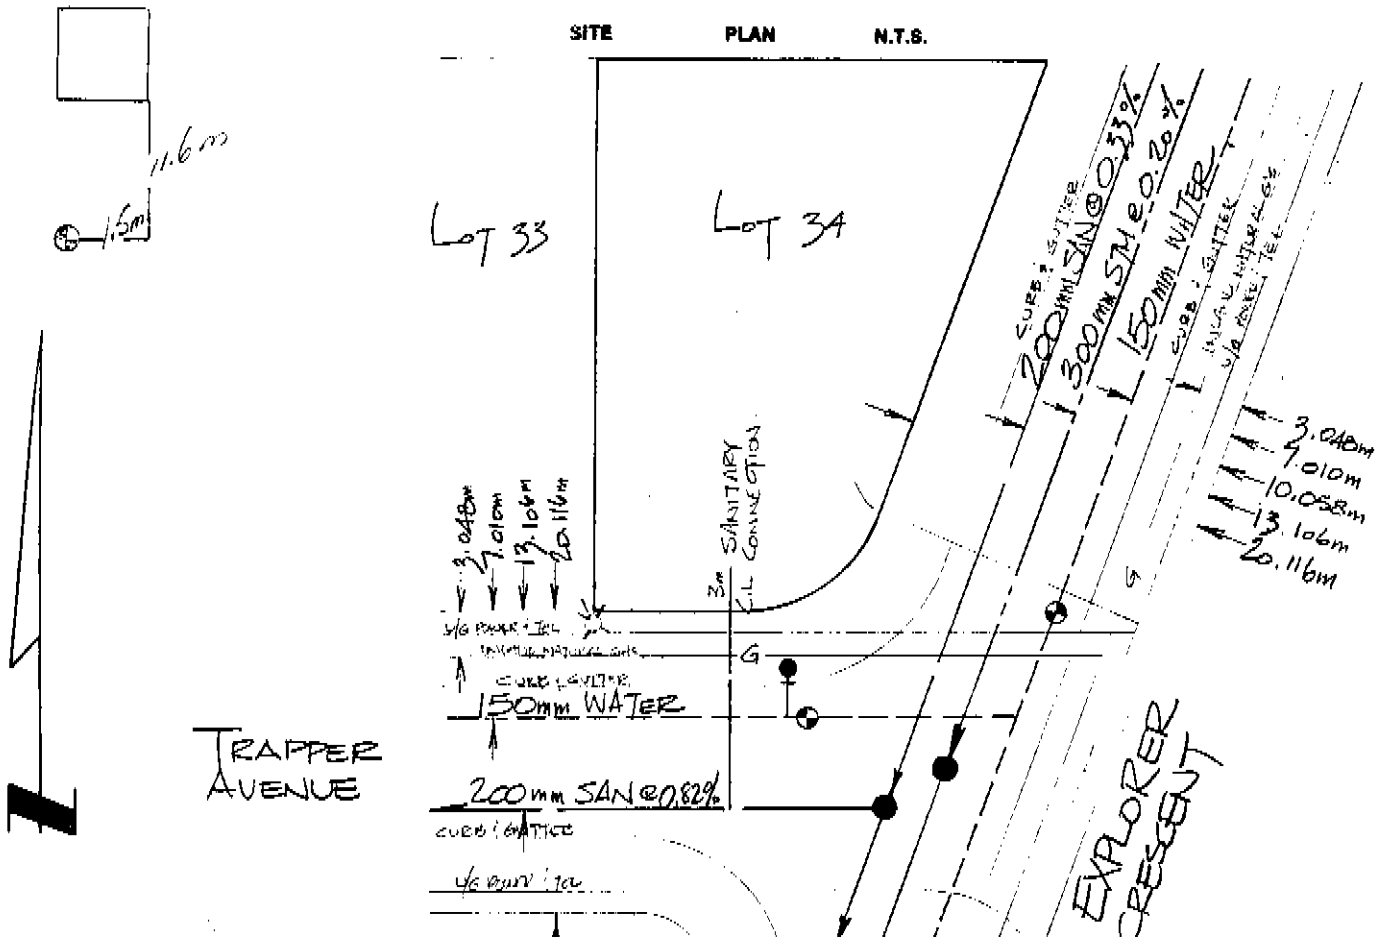
SITE PLAN N.T.S.