# City of Prince George
## HISTORY SHEET

006 132 949

SHEET NUMBER | **PID #**

**Legal:** LOT'S 229 BLOCK D.L. 936 PLAN 15185

**Address:** 1326 GARVIN ST.

**Sanitary Connection:** # 4729 SIZE 100 mm MATERIAL A.C. INV. CONNECTED

**Water Connection:** # 4729 SIZE 20 mm MATERIAL CU. METER CONNECTED

**Storm Connection:** # SIZE mm MATERIAL INV. CONNECTED

**Cash Receipt No's:** WATER PAID IN LOT PRICE SANITARY PAID IN LOT PRICE STORM

CURB FROM PROPERTY LINE 4.877 m PAVEMENT WIDTH 10.363 m

B.C. HYDRO U/G UNDERGROUND CONNECTION

B.C. TELEPHONE U/G UNDERGROUND CONNECTION

INLAND GAS AS SHOWN

**Information Sheets:**

**Comments:**
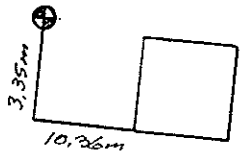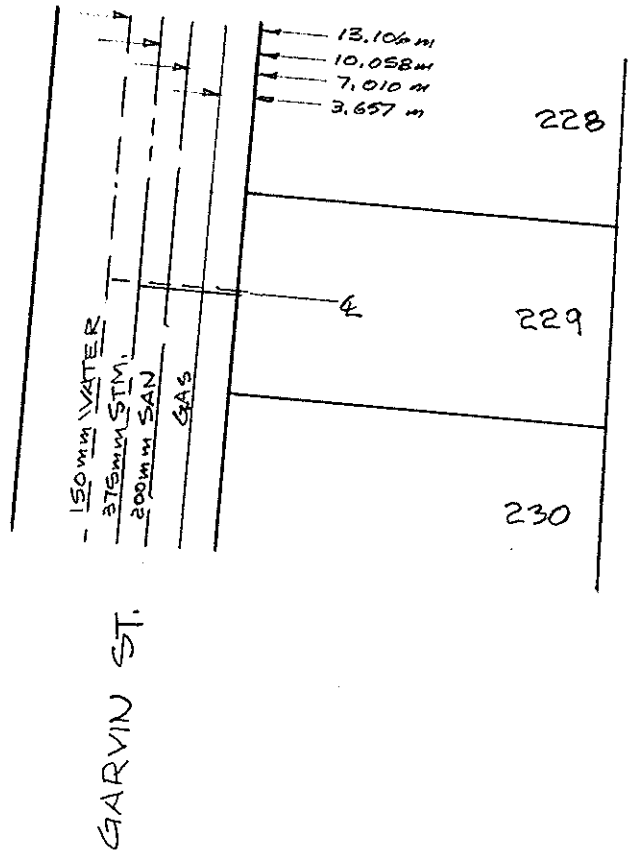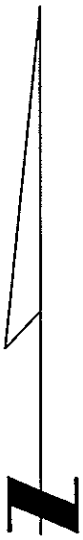
**THE INFORMATION CONTAINED HEREIN IS FOR INTERNAL USE ONLY.**
**NOT TO BE RELIED UPON UNLESS CONFIRMED BY SITE INSPECTION AND/OR INVESTIGATION**