# City of Prince George
## HISTORY SHEET

SHEET NUMBER № 4578 **Roll Number** 006166 991

**Legal:** LOT'S 15 BLOCK D.L. 4050 PLAN 26344

**Address:** 4918 MEADOWBROOK ROAD OR 4911

**Sanitary Connection:** # SIZE 100ϕ MATERIAL PVC INV. 605.81 CONNECTED

**Water Connection** # SIZE 20ϕ MATERIAL Copper METER No CONNECTED

**Storm Connection:** # SIZE MATERIAL INV. CONNECTED

**Cash Receipt No's:** WATER SANITARY STORM

CURB FROM PROPERTY LINE 5.00 PAVEMENT WIDTH 10.00

B.C. HYDRO O/S 1.3 FROM PL UNDERGROUND CONNECTION U/G - MID LOT

B.C. TELEPHONE O/S 1.6 FROM PL UNDERGROUND CONNECTION U/G - MID LOT

INLAND GAS O/S 2.9 FROM PL

**Information Sheets:**

**Comments:** BENCH MARK - HYDRANT SPINDLE OPPOSITE FAIRBURN COURT 608.075
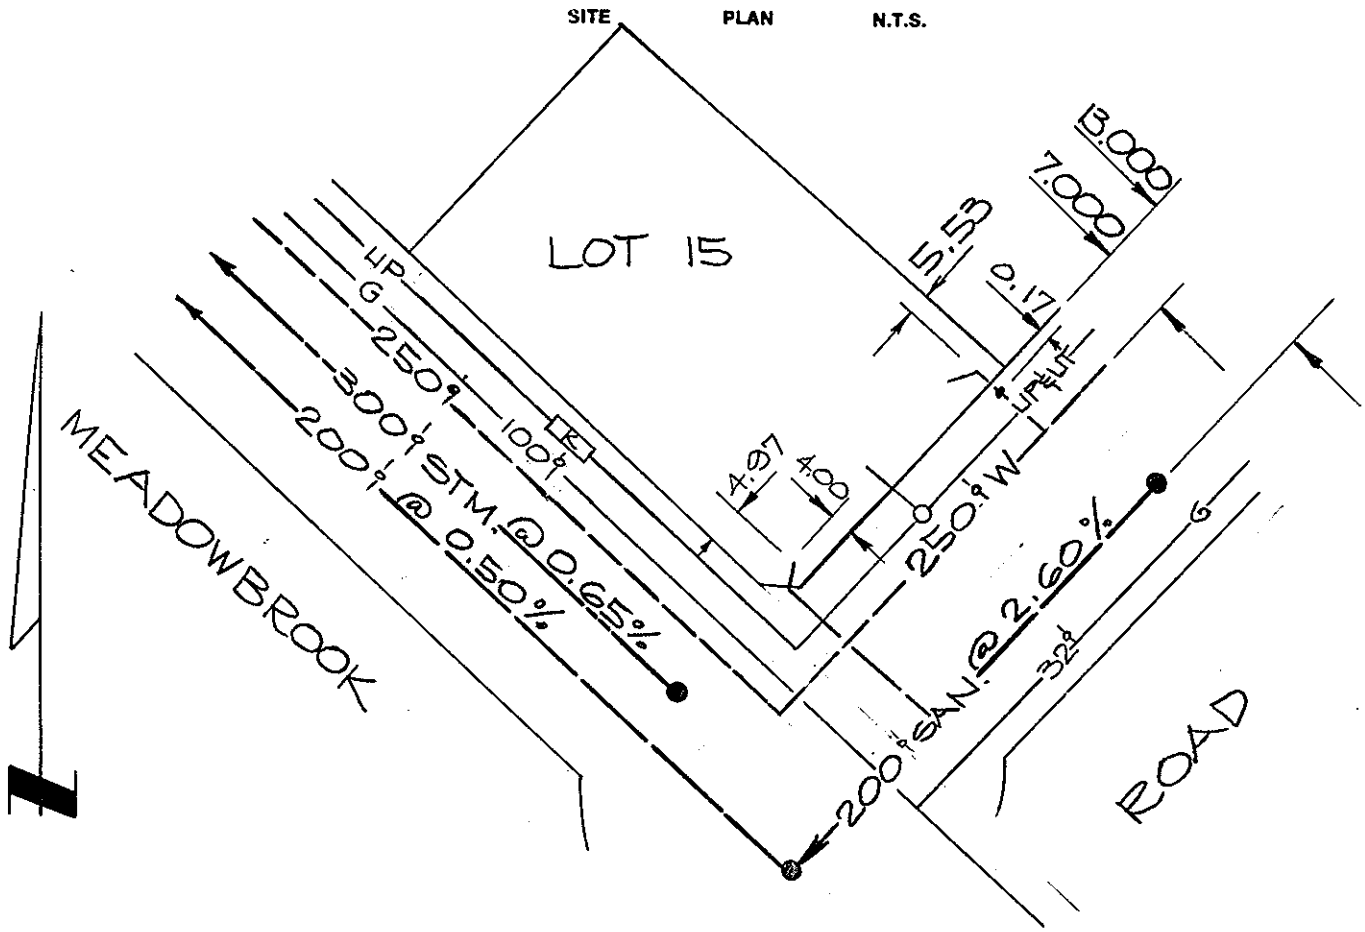
SITE PLAN N.T.S.