ASSOCIATED ENGINEERING
301 - 1777 THIRD AVENUE
PRINCE GEORGE, B.C. V2L 3G7

City of Prince George
HISTORY SHEET

SHEET NUMBER № 3040 **Roll Number** 006162

Legal: LOT'S 11 BLOCK D.L. 2045 PLAN 27990

Address: 2484 RIDGEVIEW DRIVE

Sanitary Connection: # SIZE 100 mm MATERIAL P.V.C. INV. 730.54m CONNECTED

Water Connection # SIZE 18 mm MATERIAL COPPER METER CONNECTED

Storm Connection: # SIZE MATERIAL INV. CONNECTED

Cash Receipt No's: WATER SANITARY STORM

CURB FROM PROPERTY LINE 5.0 m (ROLL CURB) PAVEMENT WIDTH 10.0 m

B.C. HYDRO UNDERGROUND CONNECTION

B.C. TELEPHONE UNDERGROUND CONNECTION

INLAND GAS

Information Sheets:

THE INFORMATION CONTAINED HEREIN IS FOR INTERNAL USE ONLY. NOT TO BE RELIED UPON UNLESS CONFIRMED BY SITE INSPECTION AND/OR INVESTIGATION.

Comments: AESL BENCH MARK: TOP F.H. SPIN ELEV = 733.885 m
@ INTER RIDGEVIEW & N. LEG
PANORAMA CRES N/E COR
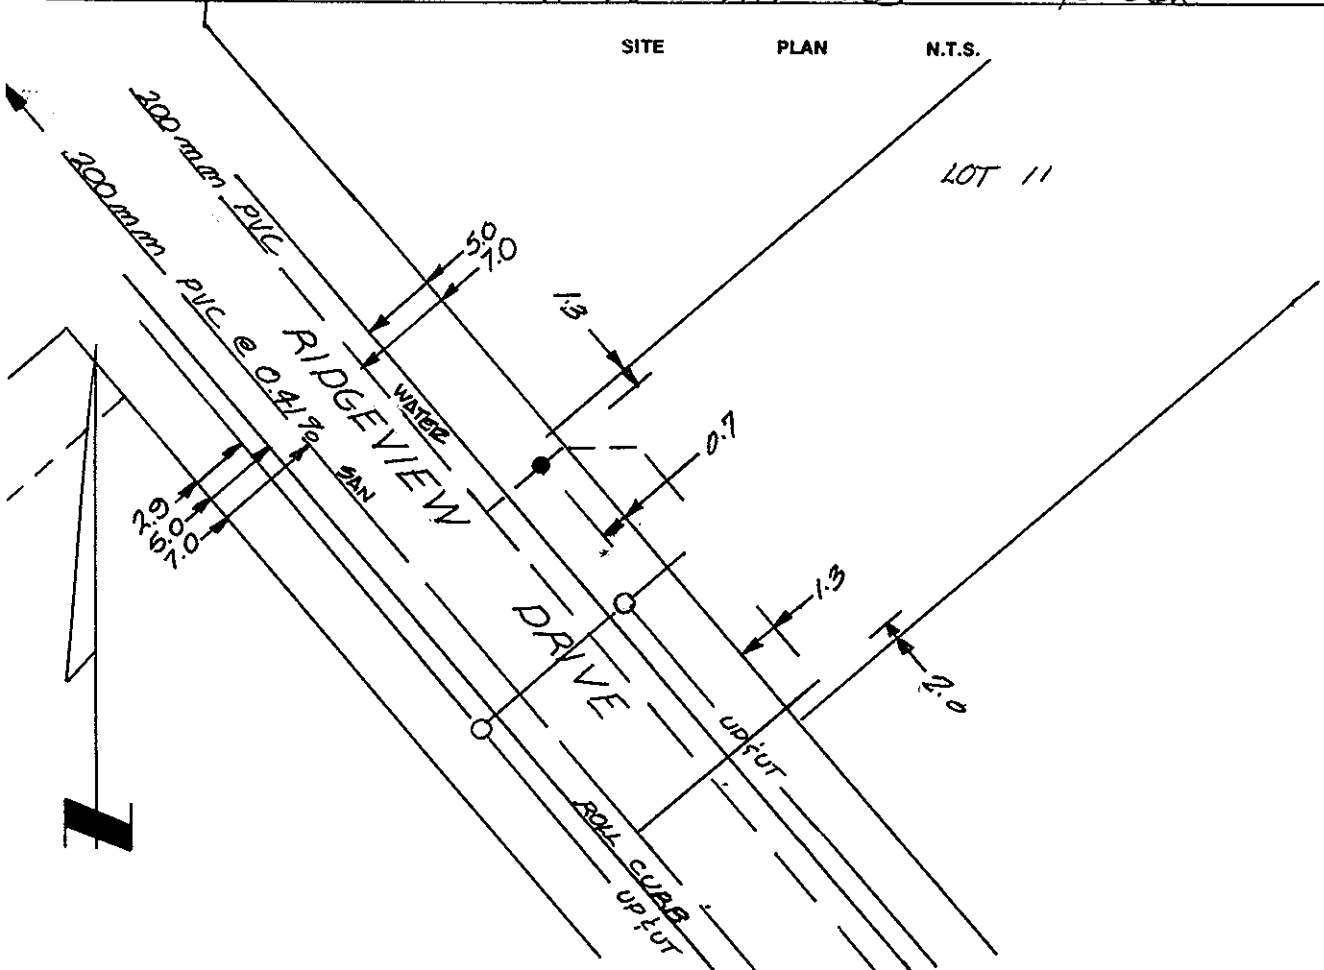
SITE PLAN N.T.S.