301 - 1777 THIRD AVENUE
PRINCE GEORGE, B.C. V2L 3G7

City of Prince George
HISTORY SHEET

SHEET NUMBER 5596 **Roll Number** 606 20/034

Legal: LOT'S 22 BLOCK D.L. 753 PLAN 25686

Address: 4127 HOLLANDIA PLACE

Sanitary Connection: # SIZE 100 MM MATERIAL P.V.C. INV. 586.02 CONNECTED

Water Connection # SIZE 19 MM MATERIAL Cu METER CONNECTED

Storm Connection: # SIZE MATERIAL INV. CONNECTED

Cash Receipt No's: WATER SANITARY STORM

CURB FROM PROPERTY LINE 5.0 METERS (ROLL CURB) PAVEMENT WIDTH 7.0 METERS

B.C. HYDRO UNDERGROUND CONNECTION

B.C. TELEPHONE UNDERGROUND CONNECTION

INLAND GAS

THE INFORMATION CONTAINED HEREIN IS FOR INTERNAL USE ONLY. NOT TO BE RELIED UPON UNLESS CONFIRMED BY SITE INSPECTION AND/OR INVESTIGATION.

Information Sheets:

Comments: CITY BM 1137 - SIP SE CORNER VANCE & KILBRIDE ELEV 587.848

LEVEL BOOK 343
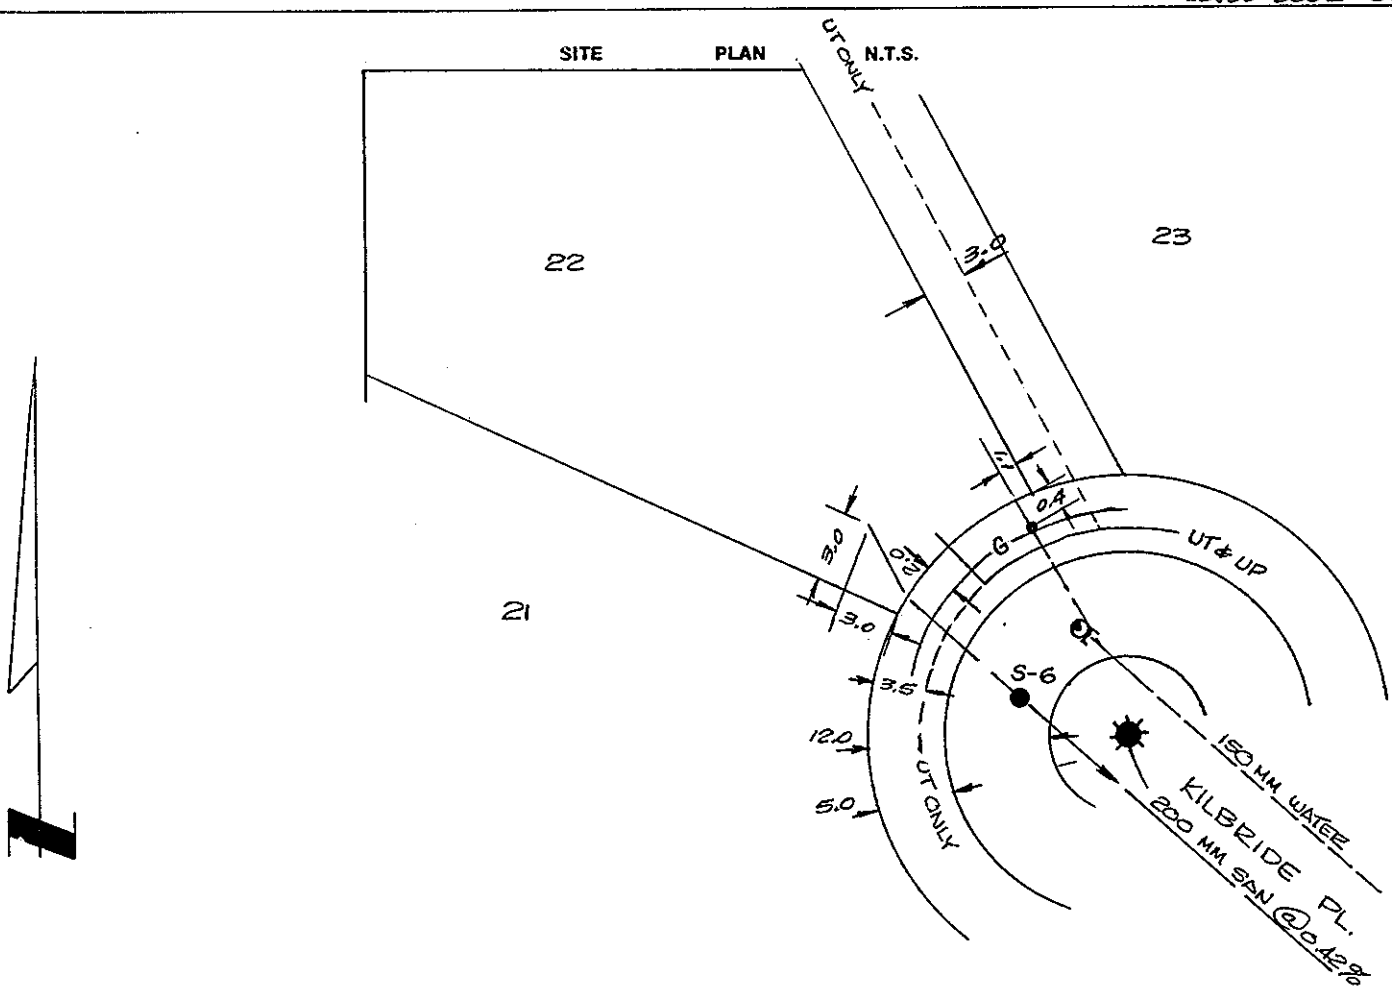
SITE PLAN N.T.S.