ASSOCIATED ENGINEERING SERVICES LTD.
301 - 1777 THIRD AVENUE
PRINCE GEORGE, B.C. V2L 3G7

City of Prince George
HISTORY SHEET

SHEET NUMBER № 3002 **Roll Number** 0062405997

Legal: LOT'S 24 BLOCK D.L. 4045 PLAN 27990

Address: 2363 SADLER DRIVE

Sanitary Connection: # SIZE 100 mm MATERIAL P.V.C INV. 726.50 m CONNECTED

Water Connection # SIZE 19mm MATERIAL COPPER METER CONNECTED

Storm Connection: # SIZE MATERIAL INV. CONNECTED

Cash Receipt No's: WATER SANITARY STORM

CURB FROM PROPERTY LINE 5.0m (ROLL CURB) PAVEMENT WIDTH 10.0m

B.C. HYDRO UNDERGROUND CONNECTION

B.C. TELEPHONE UNDERGROUND CONNECTION

INLAND GAS

Information Sheets:

Comments: AESL BENCH MARK: TOP F.H. SPIN ELEV = 733.885m
@ INTER. RIDGEVIEW & N/LEG
PANORAMA CRES N/E COR.
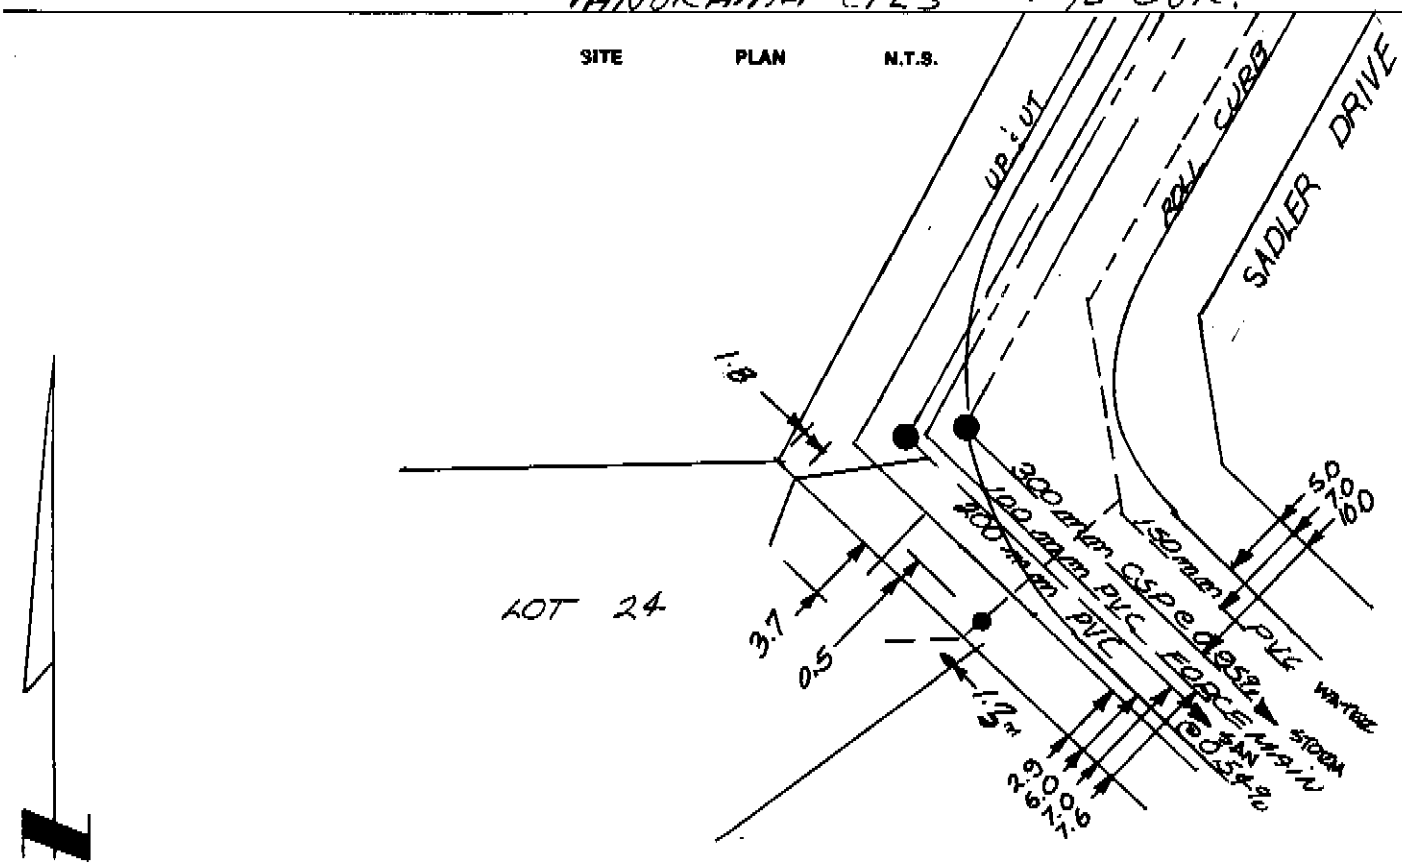
SITE PLAN N.T.S.