WILLIS, CUNLIFFE, TAIT & COMPANY LTD.
1575 - 5TH. AVE.
PRINCE GEORGE, B.C. V2L 3L9

City of Prince George
HISTORY SHEET

SHEET NUMBER № 3552 **Roll Number** 006302777

Legal: LOT'S 52 BLOCK D.L. 754 PLAN 27656

Address: 161 Bernadette

Sanitary Connection: # SIZE 4" ϕ MATERIAL P.V.C. INV. 2116.59 CONNECTED

Water Connection # SIZE 3/4" ϕ MATERIAL Cu METER CONNECTED

Storm Connection: # SIZE 4" ϕ MATERIAL P.V.C. INV. 2116.59 CONNECTED

Cash Receipt No's: WATER SANITARY STORM

CURB FROM PROPERTY LINE 15.8' (ROLL) PAVEMENT WIDTH 34'

B.C. HYDRO UNDERGROUND CONNECTION

B.C. TELEPHONE

INLAND GAS

THE INFORMATION CONTAINED HEREIN IS FOR INTERNAL USE ONLY. NOT TO BE RELIED UPON UNLESS CONFIRMED BY SITE INSPECTION AND/OR INVESTIGATION.

Information Sheets:
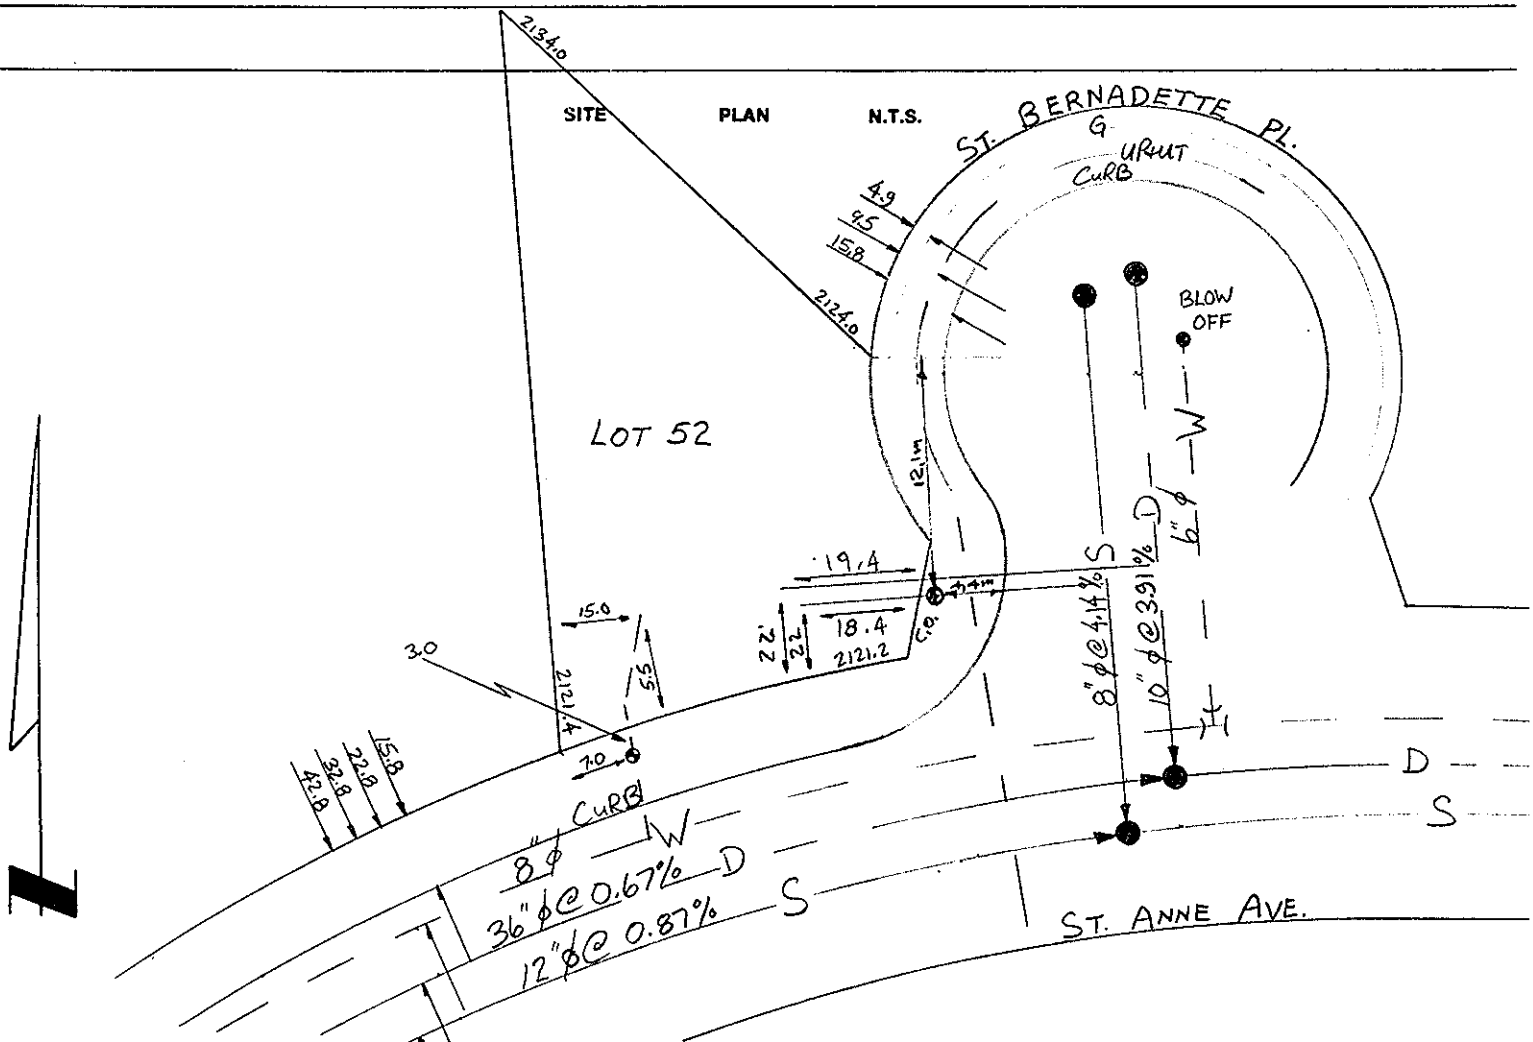
Comments: City of Prince George B.M. #1675-78 Elevation 2137.06.