WILLIS, CUNLIFFE, TAIT & COMPANY LTD.
1575 - 5TH. AVE.
PRINCE GEORGE, B.C. V2L 3L9

City of Prince George
HISTORY SHEET

SHEET NUMBER № 3541 **Roll Number** 006302963

Legal: LOT'S 41 BLOCK D.L. 754 PLAN 27656

Address: 7166 St. Clare St.

Sanitary Connection: # SIZE 4" ø MATERIAL P.V.C. NORTH 2113.07 INV. SOUTH 2113.27 CONNECTED

Water Connection # SIZE 3/4" ø MATERIAL Cu. METER CONNECTED

Storm Connection: # SIZE 4" ø MATERIAL P.V.C. NORTH 2112.97 INV. SOUTH 2113.27 CONNECTED

Cash Receipt No's: WATER SANITARY STORM

CURB FROM PROPERTY LINE 15.8' (ROLL) PAVEMENT WIDTH 34'

B.C. HYDRO UNDERGROUND CONNECTION U/G

B.C. TELEPHONE UNDERGROUND CONNECTION U/G

INLAND GAS

Information Sheets:
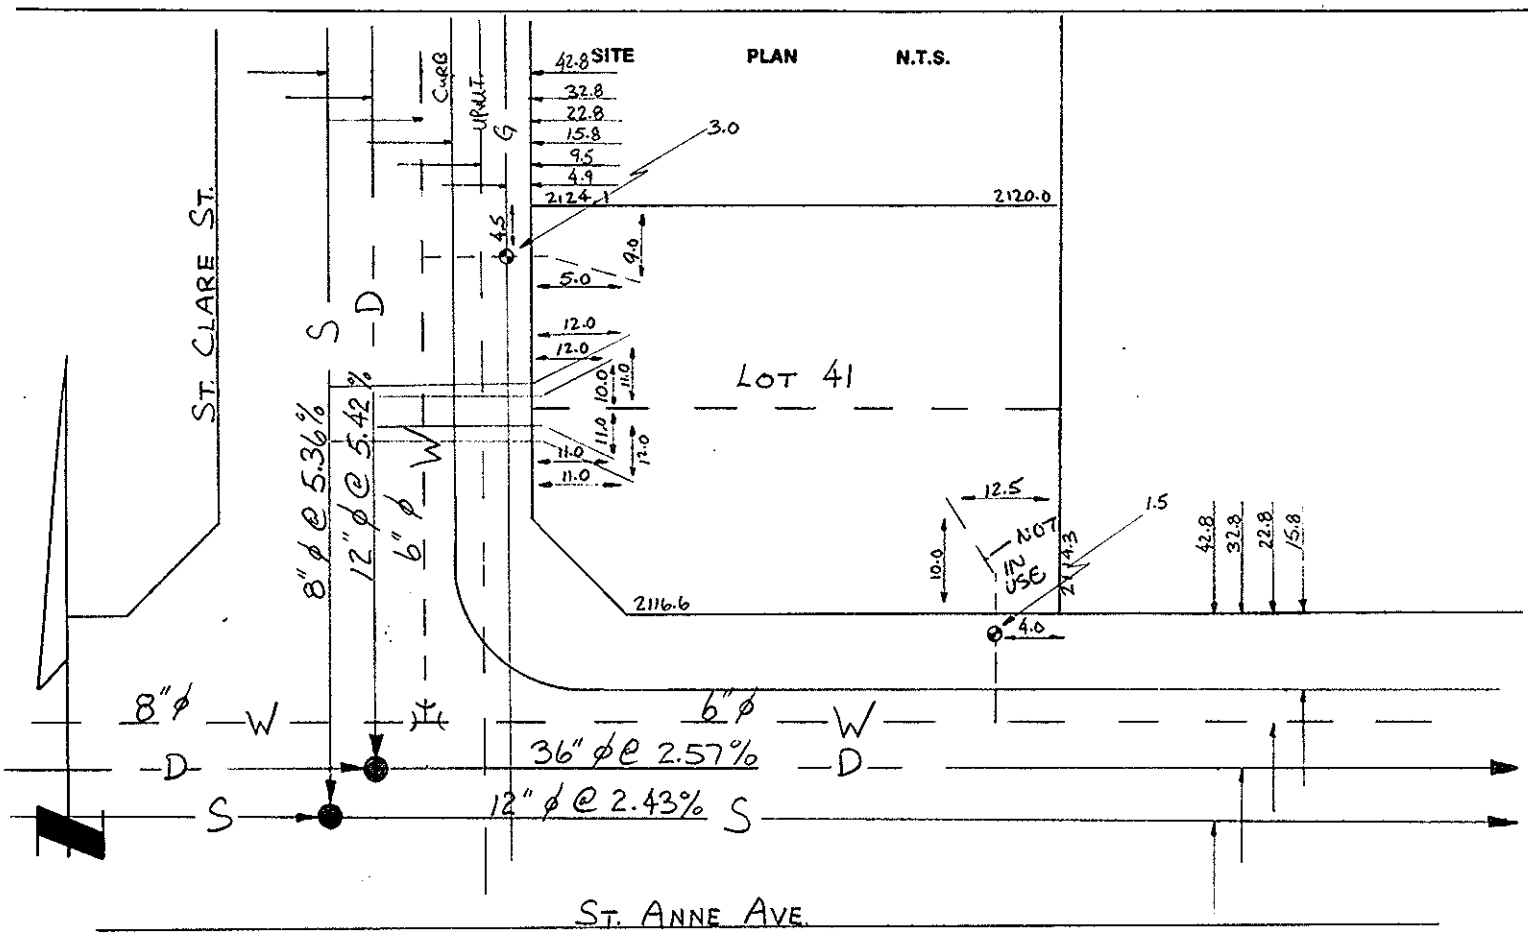
Comments: City of Prince George B.M. #1675-78 Elevation 2137.06.