WILLIS, CUNLIFFE, TAIT & COMPANY LTD.
1575 - 5TH. AVE.
PRINCE GEORGE, B.C. V2L 3L9

City of Prince George
HISTORY SHEET

SHEET NUMBER № 3545 **Roll Number** 006303081

Legal: LOT'S 45 BLOCK D.L. 754 PLAN 27656

Address: 7143 ST CLARE ST

Sanitary Connection: # SIZE 4"ø MATERIAL P.V.C. NORTH 2127.80 INV. SOUTH 2127.40 CONNECTED

Water Connection # SIZE 3/4"ø MATERIAL Cu METER CONNECTED

Storm Connection: # SIZE 4"ø MATERIAL P.V.C. NORTH 2127.60 INV. SOUTH 2127.40 CONNECTED

Cash Receipt No's: WATER SANITARY STORM

CURB FROM PROPERTY LINE 15.8' (ROLL) PAVEMENT WIDTH 34'

B.C. HYDRO UNDERGROUND CONNECTION U/G

B.C. TELEPHONE UNDERGROUND CONNECTION U/G

INLAND GAS

Information Sheets:

Comments: City of Prince George B.M. #1675-78 Elevation 2137.06.
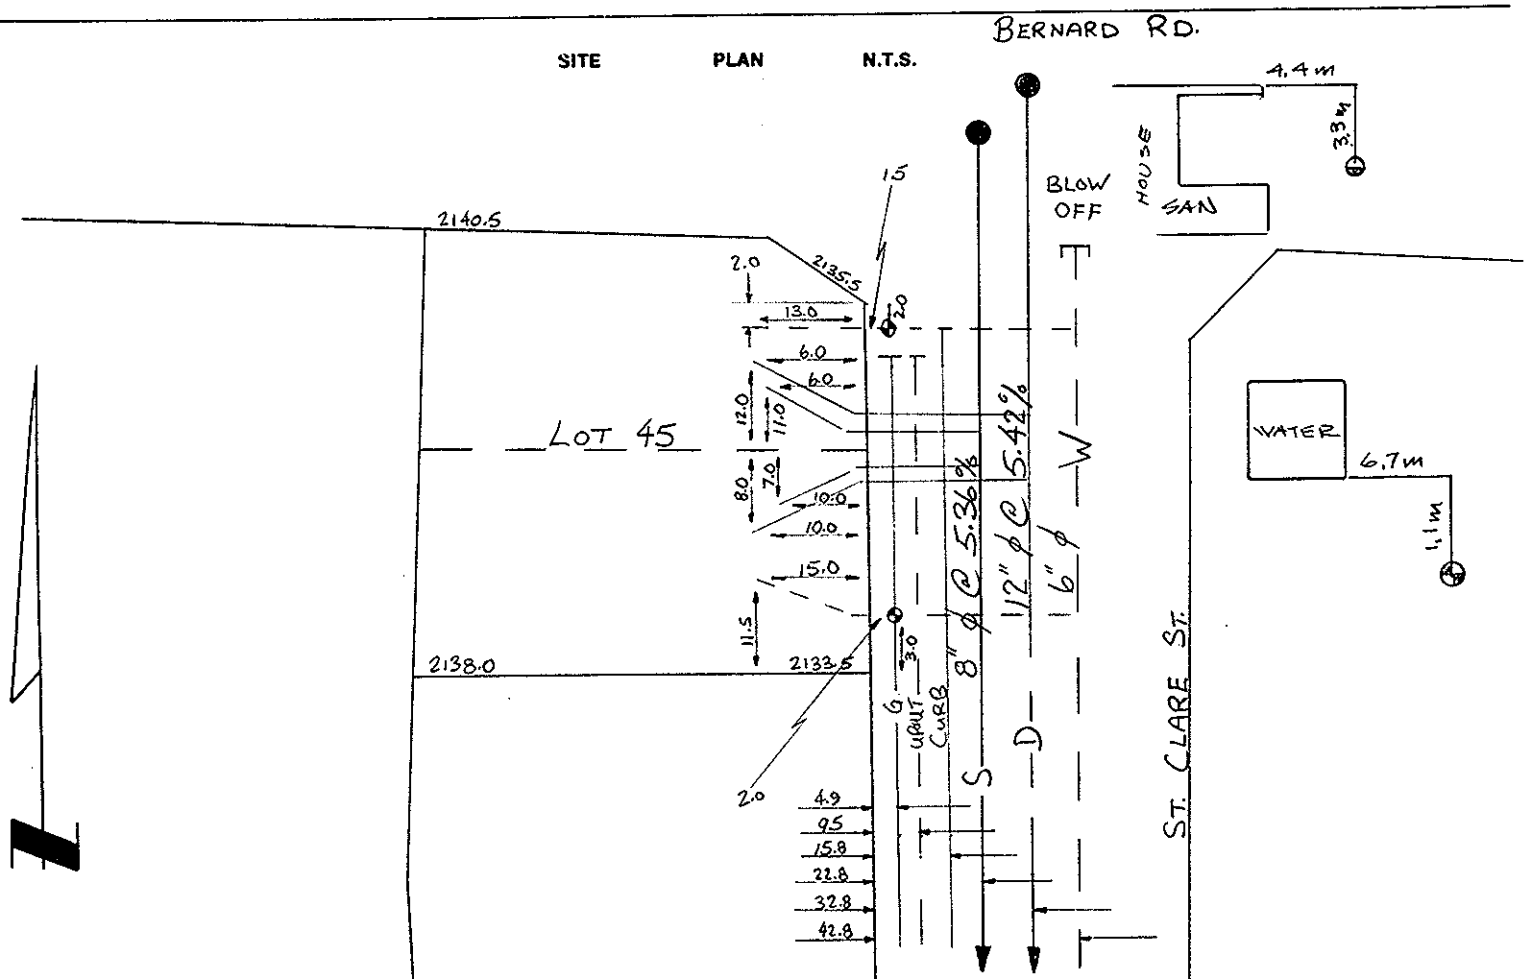
SITE PLAN N.T.S.