City of Prince George
HISTORY SHEET

006321232

SHEET NUMBER 7255 **Roll Number**

Legal: LOT'S A BLOCK — D.L. 2424 PLAN 32043

Address: 8296 DOMAGALA RD.

Sanitary Connection: # SIZE MATERIAL INV. CONNECTED

Water Connection # SIZE 3/4" MATERIAL COPPER METER CONNECTED

Storm Connection: # SIZE MATERIAL INV. CONNECTED

Cash Receipt No's: WATER SANITARY STORM

CURB FROM PROPERTY LINE PAVEMENT WIDTH

B.C. HYDRO UNDERGROUND CONNECTION

B.C. TELEPHONE UNDERGROUND CONNECTION

INLAND GAS

Information Sheets:

Comments:

OWNER: DOMAGALA HOLDINGS
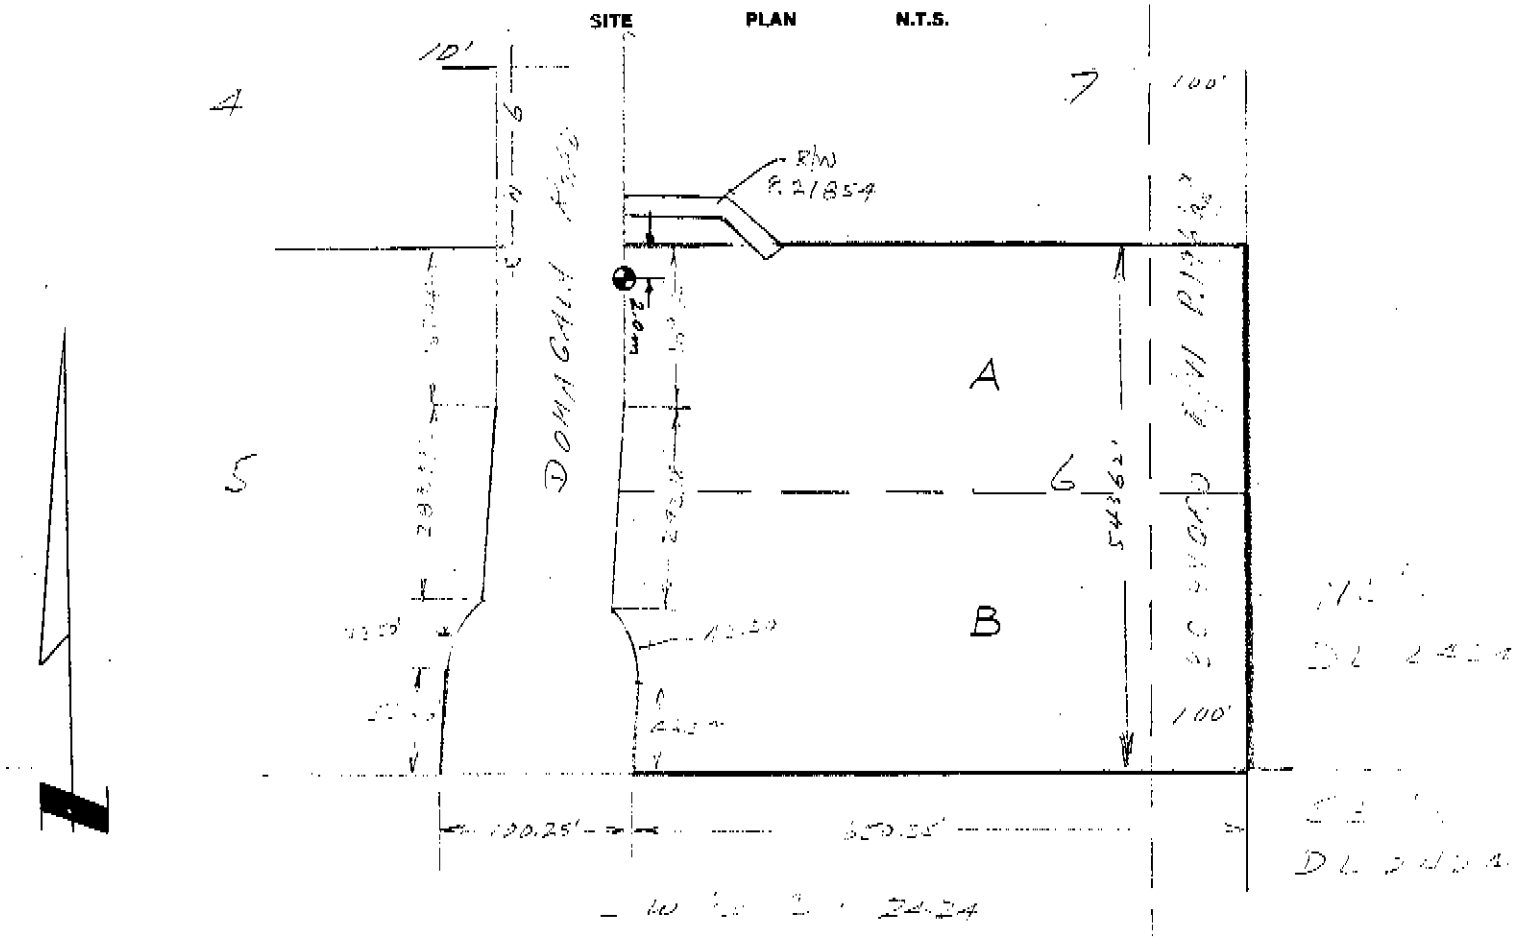
SITE PLAN N.T.S.