City of Prince George
HISTORY SHEET

SHEET NUMBER № 3180 **Roll Number** 006368620

Legal: LOT'S 1 BLOCK D.L. 8177 PLAN 27589

Address: 2900 CHRISTOPHER CRES.

Sanitary Connection: # SIZE 100mm MATERIAL PVC INV. 595.40 CONNECTED

Water Connection # SIZE 18mm MATERIAL copper METER CONNECTED

Storm Connection: # SIZE MATERIAL INV. CONNECTED

Cash Receipt No's: WATER SANITARY STORM

CURB FROM PROPERTY LINE 5m PAVEMENT WIDTH 10m

B.C. HYDRO UNDERGROUND CONNECTION

B.C. TELEPHONE UNDERGROUND CONNECTION

INLAND GAS

Information Sheets:

Comments: B.M. MON @ N/E COR. MELODY & OSPIKA: 594.75
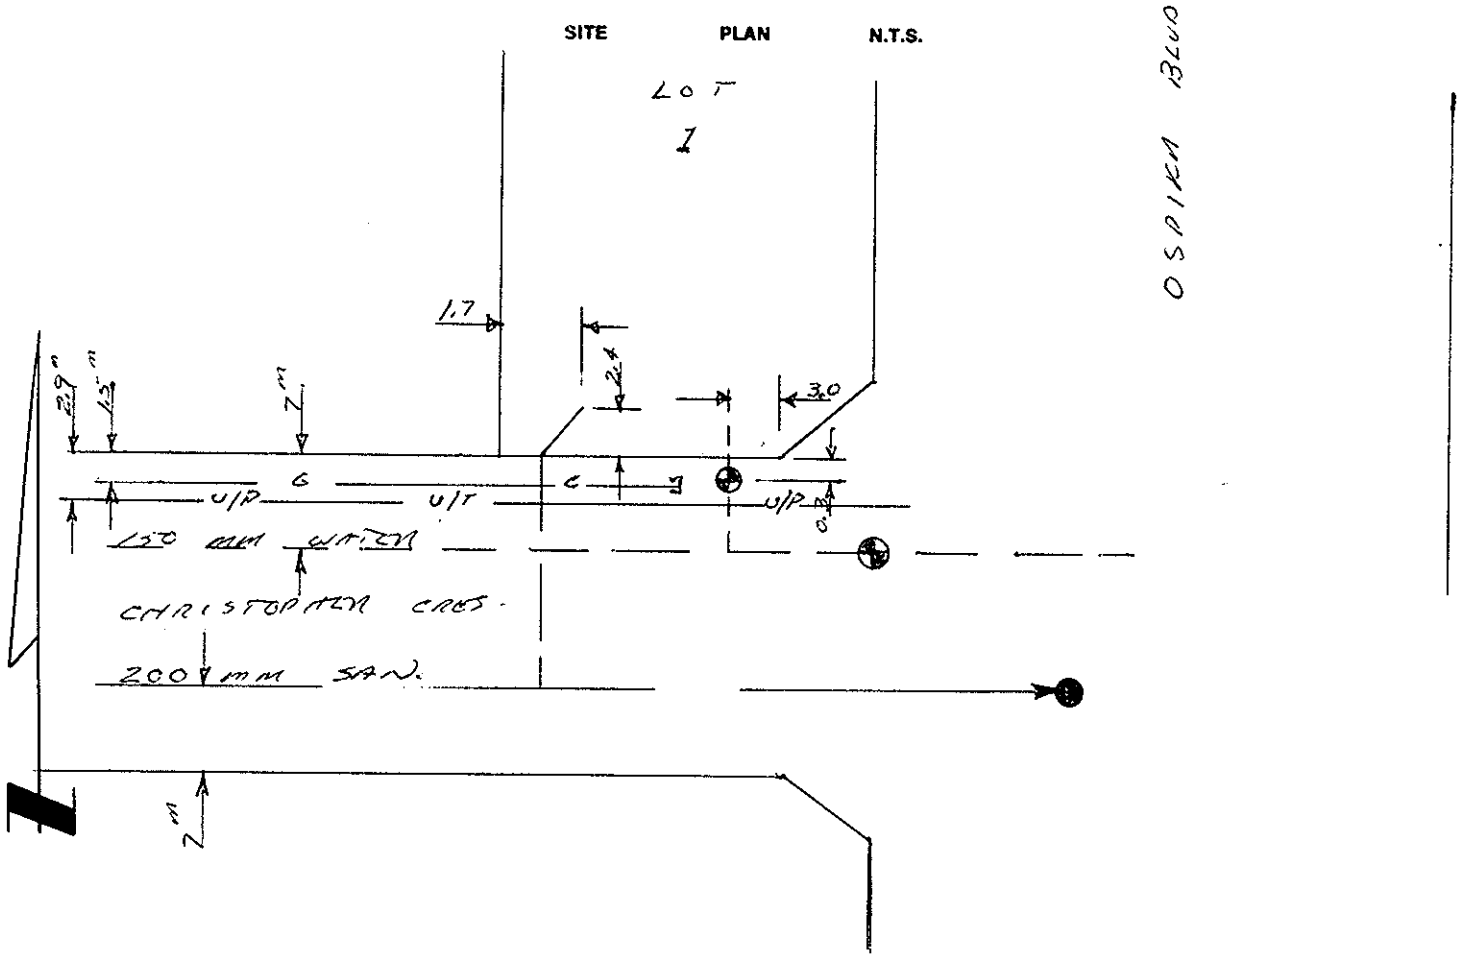
SITE PLAN N.T.S.