City of Prince George
HISTORY SHEET

SHEET NUMBER **Roll Number** 006.380.395

Legal: LOT'S 32 BLOCK D.L. 8177 PLAN 27589

Address: CHRISTOPHER CRESCENT

Sanitary Connection: # SIZE 100 mm MATERIAL PVC INV. 596.25 CONNECTED

Water Connection # SIZE 18 mm MATERIAL COPPER METER CONNECTED

Storm Connection: # SIZE MATERIAL INV. CONNECTED

Cash Receipt No's: WATER SANITARY STORM

CURB FROM PROPERTY LINE 5 m PAVEMENT WIDTH 10 m

B.C. HYDRO UNDERGROUND CONNECTION

B.C. TELEPHONE UNDERGROUND CONNECTION

INLAND GAS

Information Sheets:

Comments: BM: MON @ N/E COR. MEADOW & OSPIKA = 594.75
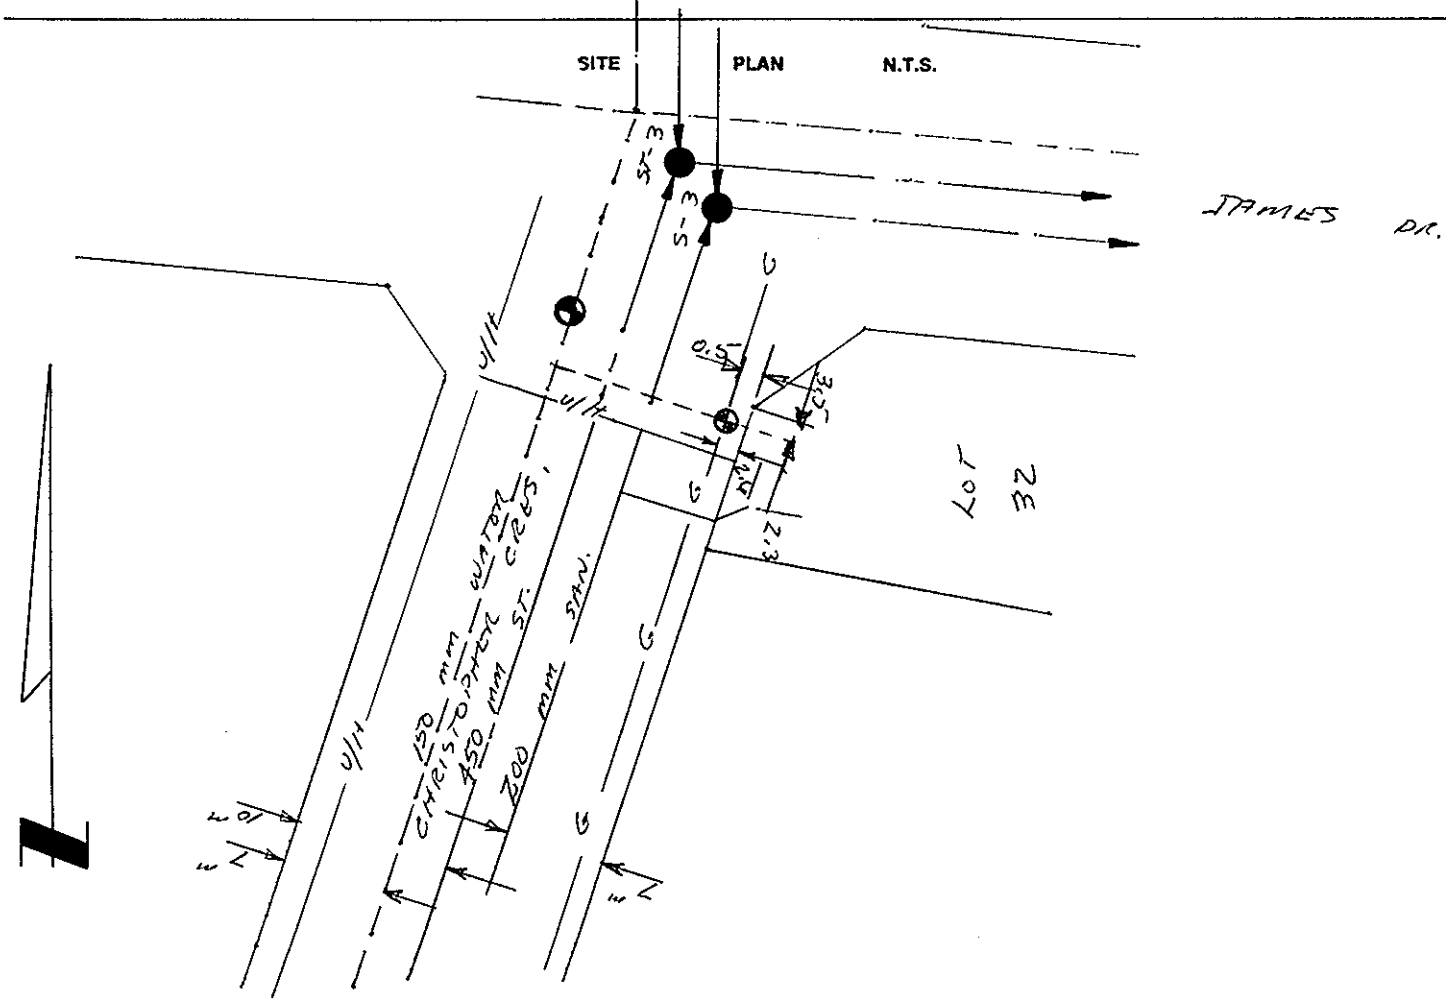
SITE PLAN N.T.S.