City of Prince George
HISTORY SHEET

006406513

SHEET NUMBER № 1061 **Roll Number** 530

Legal: LOT'S 3-4 BLOCK 36 D.L. 1429 PLAN 646

Address: 877-885 HARPER ST.

Sanitary Connection: # 4320 SIZE 100mm MATERIAL A.C.S. INV. CONNECTED

Water Connection # 1740-4100 SIZE 13mm (1740) 19mm (4100) MATERIAL COPPER METER CONNECTED

Storm Connection: # SIZE MATERIAL INV. CONNECTED

Cash Receipt No's: WATER 2264 SANITARY 2263 STORM

CURB FROM PROPERTY LINE PAVEMENT WIDTH

B.C. HYDRO UNDERGROUND CONNECTION

B.C. TELEPHONE UNDERGROUND CONNECTION

INLAND GAS

Information Sheets:

Comments:
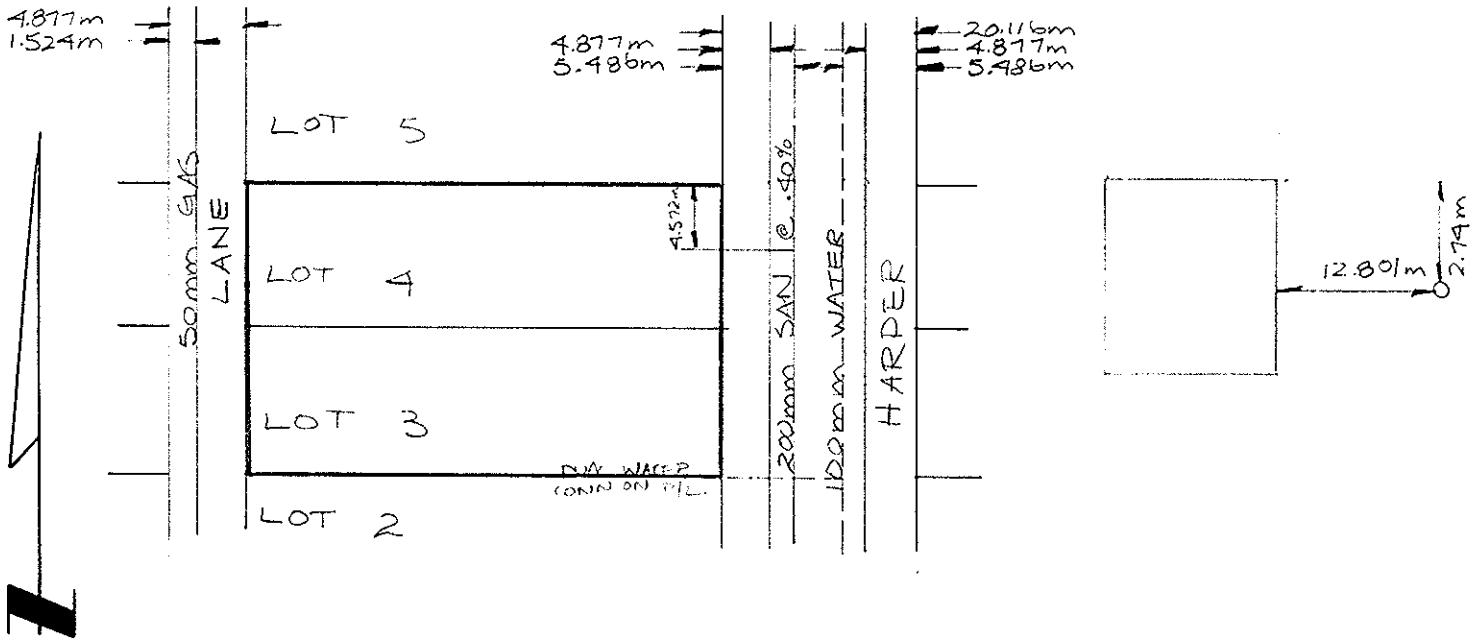
SITE PLAN N.T.S.