City of Prince George
HISTORY SHEET

SHEET NUMBER № 4519 **Roll Number** 0064146 094

Legal: LOT'S 7 BLOCK D.L. 4047 PLAN 27508

Address: 3044 WHITE SAIL

Sanitary Connection: # SIZE 100mm MATERIAL PVC INV. 729.72 CONNECTED

Water Connection # SIZE 20mm MATERIAL Cu METER CONNECTED

Storm Connection: # SIZE 100mm MATERIAL PVC INV. 729.72 CONNECTED

Cash Receipt No's: WATER SANITARY STORM

CURB FROM PROPERTY LINE 50.0m (Roll Curb) PAVEMENT WIDTH 10.0m

B.C. HYDRO UNDERGROUND CONNECTION U/G Mid Lot

B.C. TELEPHONE UNDERGROUND CONNECTION U/G MId Lot

INLAND GAS 1.5m o/s

THE INFORMATION CONTAINED HEREIN IS FOR INTERNAL USE ONLY. NOT TO BE RELIED UPON UNLESS CONFIRMED BY SITE INSPECTION AND/OR INVESTIGATION.

Information Sheets:

Comments: Bench Mark elevation 732.520m hydrant spindle N.E. corner Driftwood and Cul-de-sac.
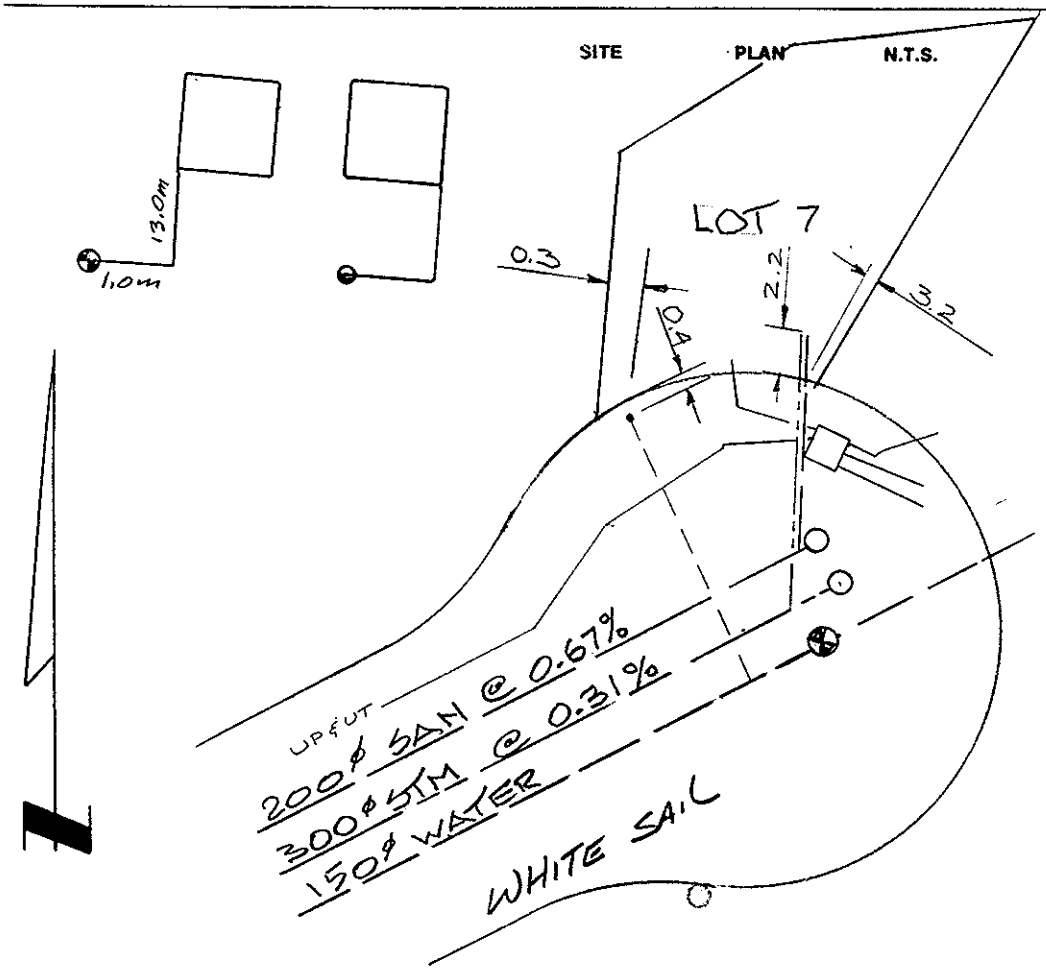
SITE PLAN N.T.S.