City of Prince George
HISTORY SHEET

SHEET NUMBER № 1119 **Roll Number**

Legal: LOT'S 13 - 16 BLOCK 47 D.L. 1429 PLAN 646.

Address: 1016 - 24 JOHNSON ST.

Sanitary Connection: # 4138 SIZE 100mm MATERIAL A.C.S. INV. CONNECTED

Water Connection # 4363 SIZE 38mm MATERIAL COPPER METER # 147 - 25mm CONNECTED

Storm Connection: # SIZE MATERIAL INV. CONNECTED

Cash Receipt No's: WATER 2375 SANITARY 2376 STORM

CURB FROM PROPERTY LINE PAVEMENT WIDTH

B.C. HYDRO UNDERGROUND CONNECTION

B.C. TELEPHONE UNDERGROUND CONNECTION

INLAND GAS

Information Sheets:

Comments:
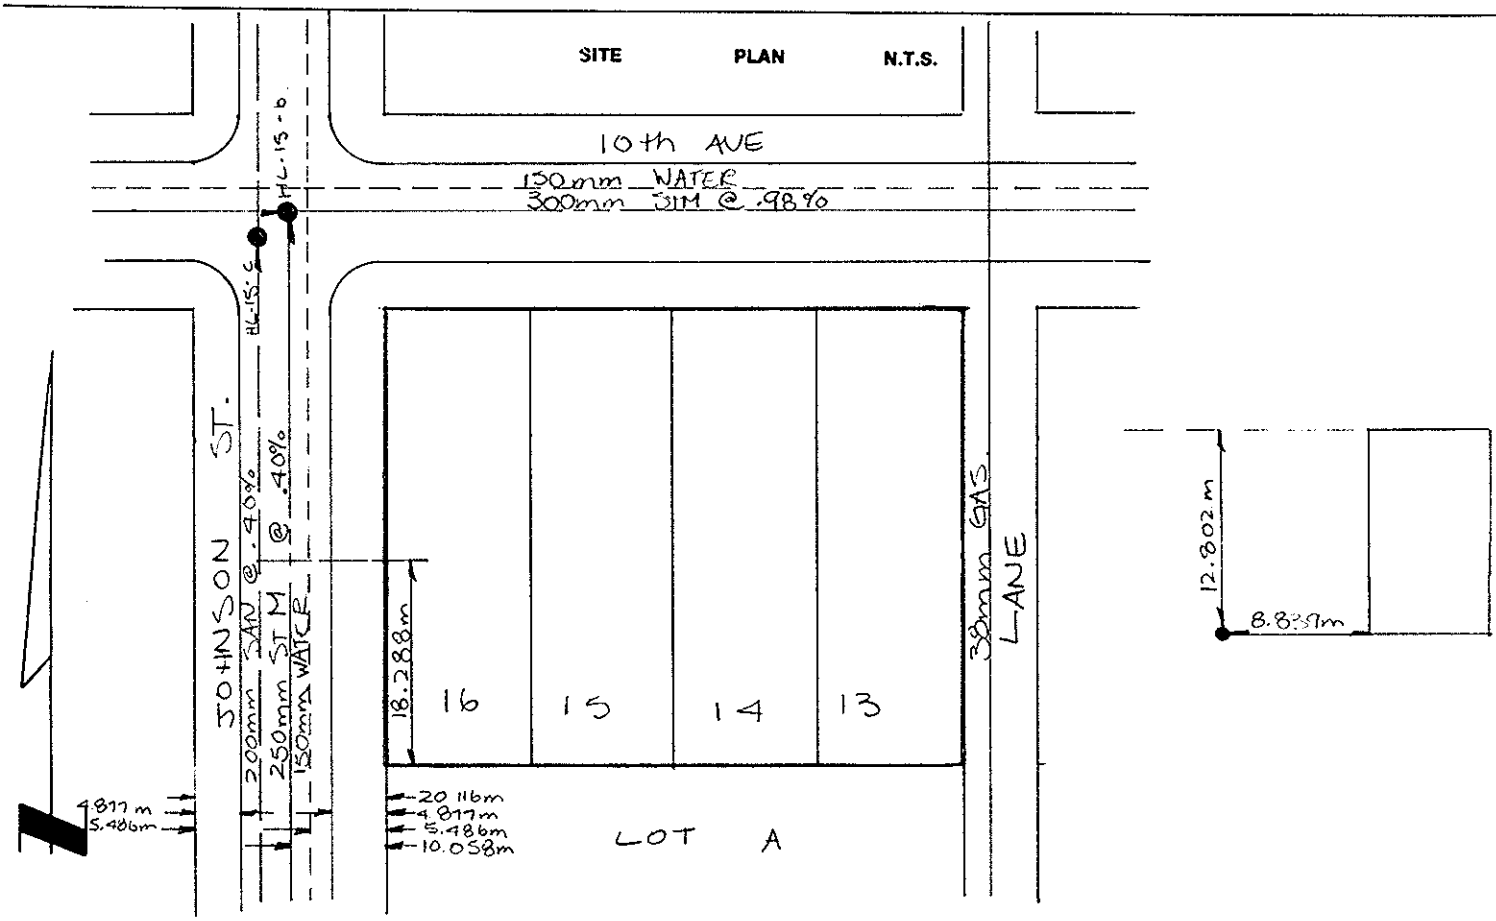
The information contained herein is for internal use only. Not to be relied upon unless confirmed by site inspection and/or investigation.