DS

City of Prince George
HISTORY SHEET

SHEET NUMBER № 4623 **Roll Number** 0065070 34

Legal: LOT'S 40 BLOCK D.L. 1433 PLAN 27430

Address: 3527 ROMANIN CRES

Sanitary Connection: # SIZE 100 ϕ MATERIAL PVC INV. 588.17 CONNECTED

Water Connection # SIZE 20 ϕ MATERIAL COPPER METER CONNECTED

Storm Connection: # SIZE MATERIAL INV. CONNECTED

Cash Receipt No's: WATER SANITARY STORM

CURB FROM PROPERTY LINE 5 m (ROLL CURB) PAVEMENT WIDTH 10 m

B.C. HYDRO UNDERGROUND CONNECTION U/G - MIDLOT

B.C. TELEPHONE UNDERGROUND CONNECTION U/G - MIDLOT

INLAND GAS 1.5 m O/S

Information Sheets:

Comments: BENCHMARK ELEV. 591.030 m

H.S. N-SIDE RANGE ROAD ; W. OF RANGE PLACE
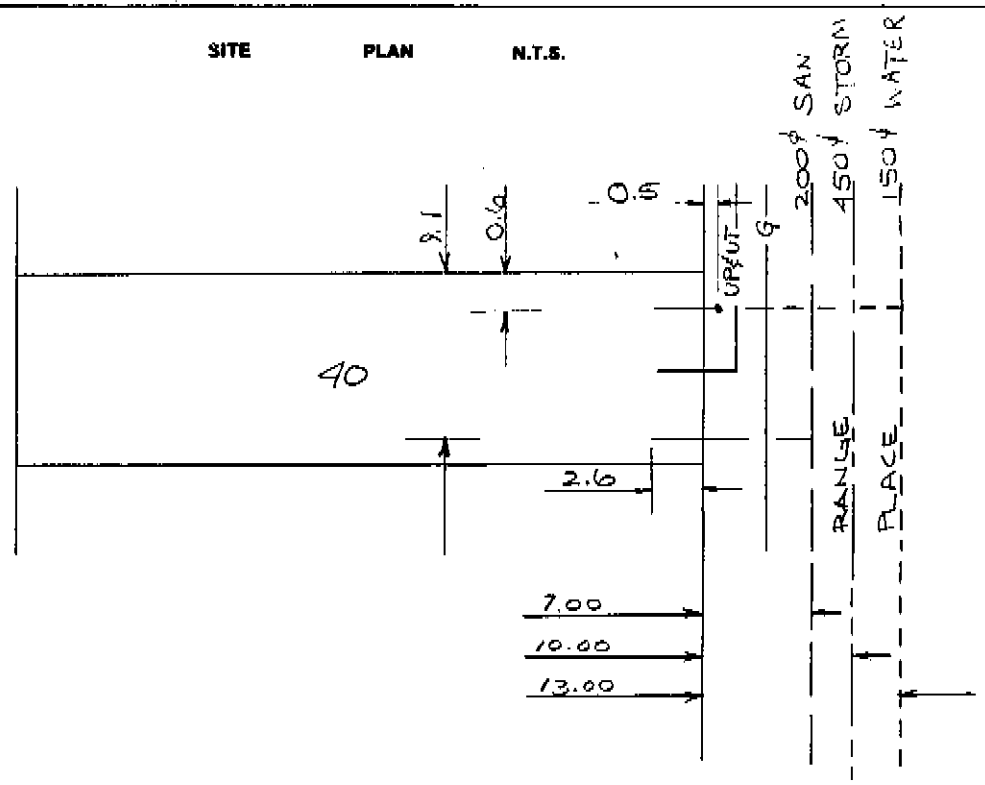
SITE PLAN N.T.S.