City of Prince George
HISTORY SHEET

006513097

SHEET NUMBER 11038 **Roll Number**

Legal: LOT'S 1 BLOCK D.L. 4040 PLAN 27476

Address: 3521 PERRIN RD.

Sanitary Connection: # 13112 SIZE 4" Ø MATERIAL A.C. INV. 2121.11 CONNECTED

Water Connection # SIZE 3/4 MATERIAL Copper METER CONNECTED

Storm Connection: # SIZE MATERIAL INV. CONNECTED

Cash Receipt No's: WATER SANITARY 1763 STORM

CURB FROM PROPERTY LINE PAVEMENT WIDTH

B.C. HYDRO UNDERGROUND CONNECTION

B.C. TELEPHONE UNDERGROUND CONNECTION

INLAND GAS

Information Sheets:

Comments:
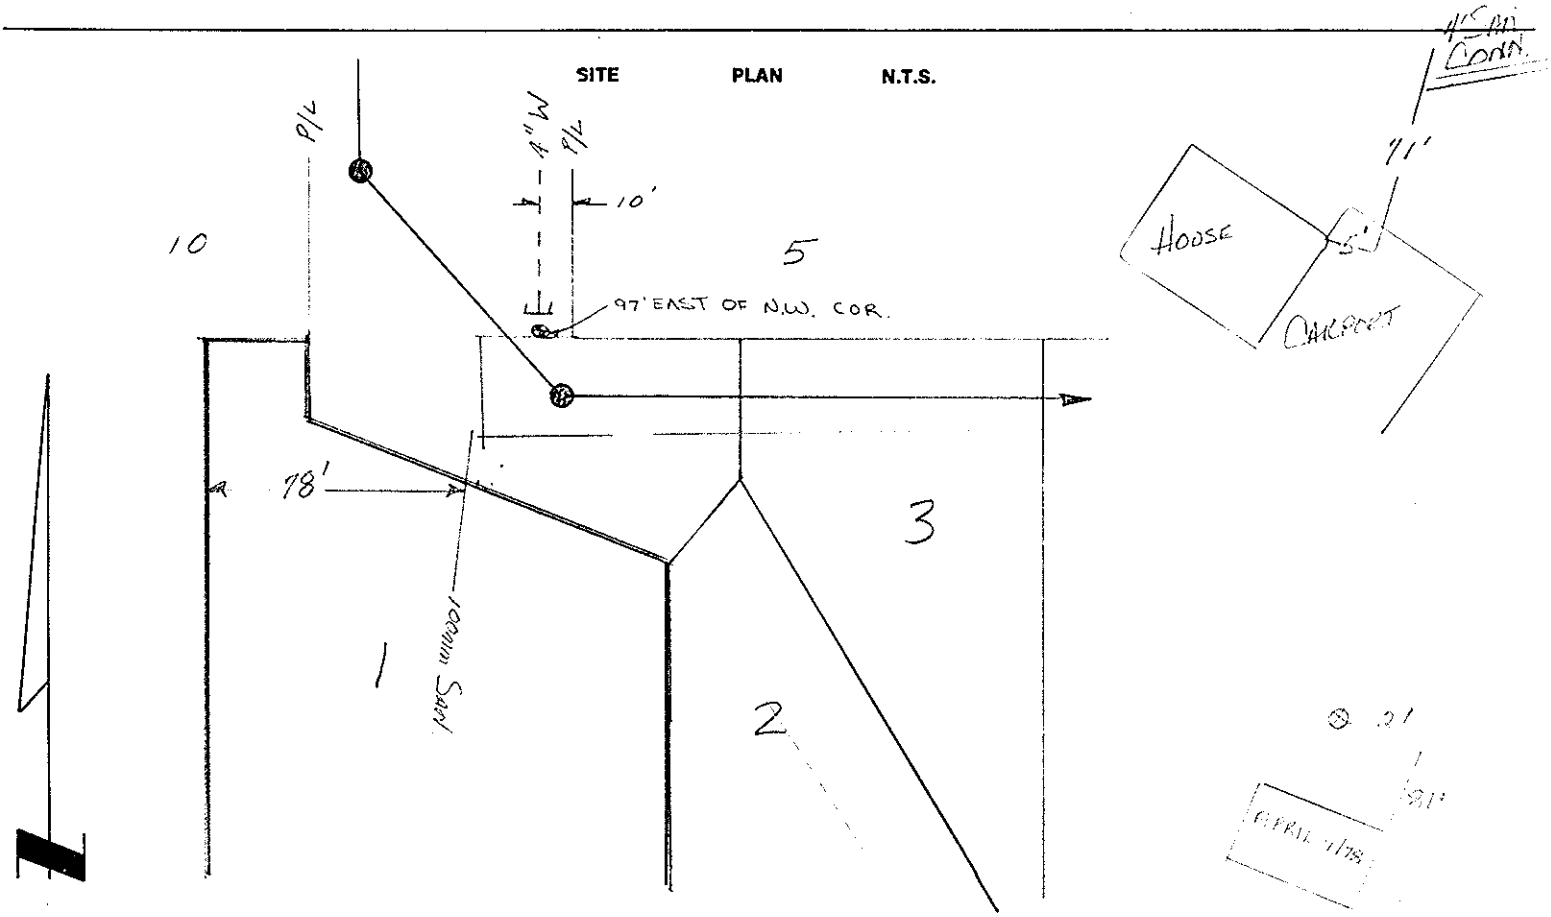
SITE PLAN N.T.S.