WILLIS, CUNLIFFE, TAIT & COMPANY LTD
1575 - 5TH. AVE.
PRINCE GEORGE, B.C. V2L 3L9

City of Prince George
HISTORY SHEET

SHEET NUMBER № 0330 **Roll Number** 006513743

Legal: LOT'S 80 BLOCK D.L. 2611 PLAN 27420

Address: 3740 JAMES

Sanitary Connection: # SIZE 100 mm ϕ MATERIAL P.V.C. INV. 598.67 CONNECTED

Water Connection # SIZE 19mm ϕ MATERIAL Cu. METER CONNECTED

Storm Connection: # SIZE MATERIAL INV. CONNECTED

Cash Receipt No's: WATER SANITARY STORM

CURB FROM PROPERTY LINE 5.0 m (ROLL) PAVEMENT WIDTH 7m.

B.C. HYDRO UNDERGROUND CONNECTION MID LOT

B.C. TELEPHONE UNDERGROUND CONNECTION MID LOT.

INLAND GAS

Information Sheets:

Comments:
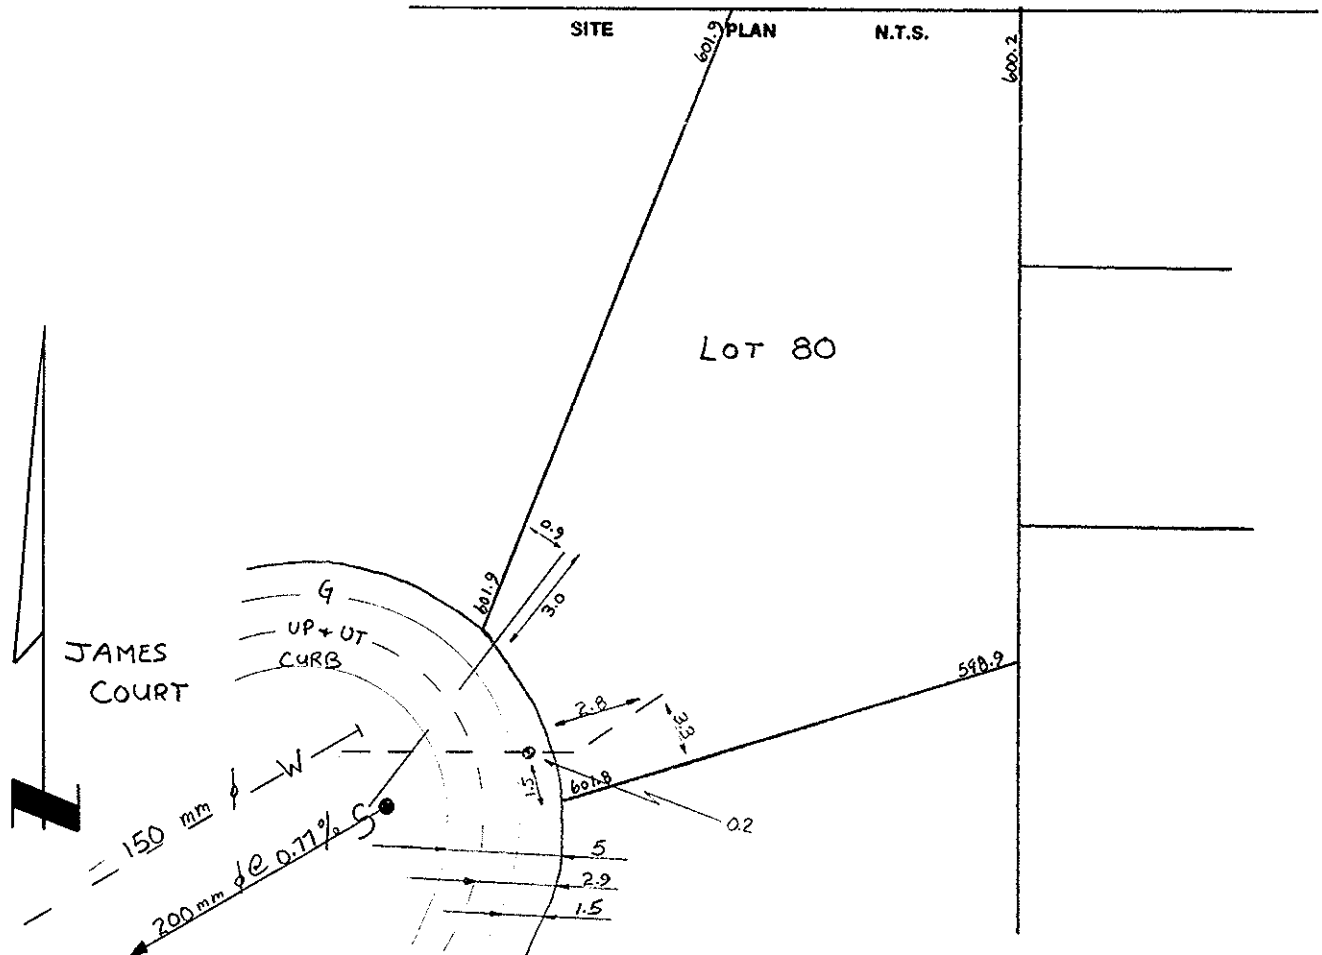
SITE PLAN N.T.S.