WILLIS, CUNLIFFE, TAIT & COMPANY LTD.
1575 - 5TH. AVE.
PRINCE GEORGE, B.C. V2L 3L9

# City of Prince George
## HISTORY SHEET

SHEET NUMBER № 0304 Roll Number 006518842

**Legal:** LOT'S 54 BLOCK D.L. 9265 PLAN 27420

**Address:** 2963 WAYNE STREET

**Sanitary Connection:** # SIZE 100 mm ϕ MATERIAL P.V.C. INV. 596.01 CONNECTED

**Water Connection** # SIZE 19 mm ϕ MATERIAL Cu. METER CONNECTED

**Storm Connection:** # SIZE MATERIAL CMP INV. CONNECTED

**Cash Receipt No's:** WATER SANITARY STORM

CURB FROM PROPERTY LINE 5.0 m (ROLL) PAVEMENT WIDTH 10 m.

B.C. HYDRO UNDERGROUND CONNECTION MID LOT

B.C. TELEPHONE UNDERGROUND CONNECTION MID LOT

INLAND GAS

**Information Sheets:**

**Comments:** THE INFORMATION CONTAINED HEREIN IS FOR INTERNAL USE ONLY. NOT TO BE RELIED UPON UNLESS CONFIRMED BY SITE INSPECTION AND/OR INVESTIGATION.
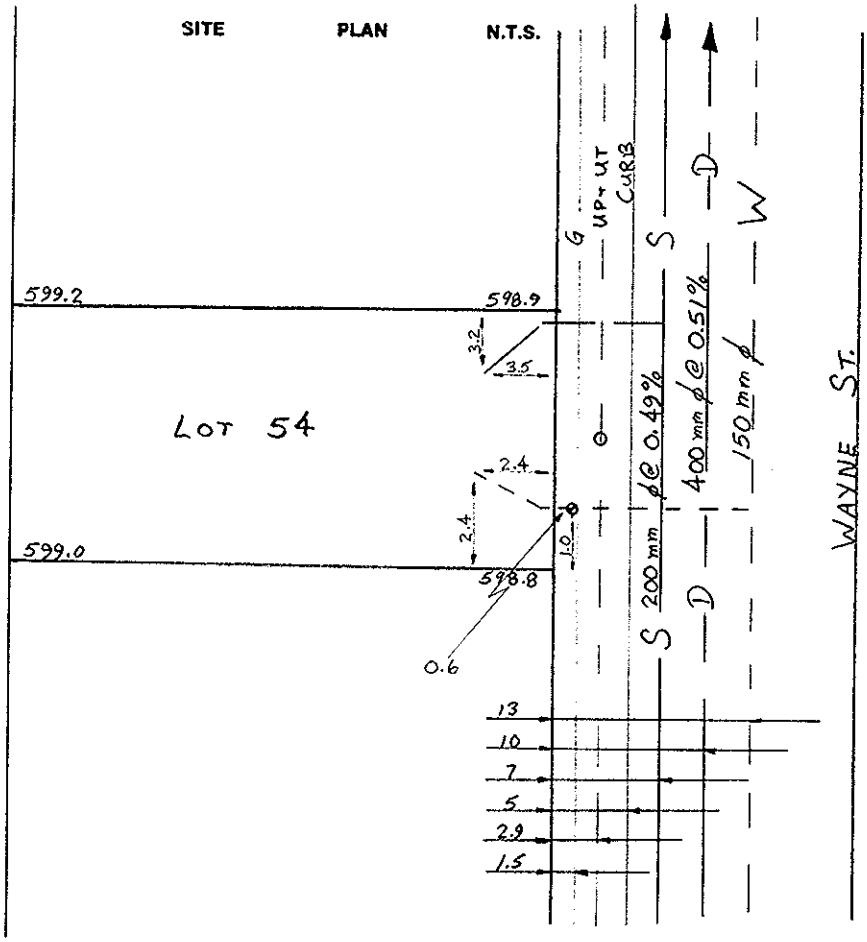
SITE PLAN N.T.S.