WILLIS, CUNLIFFE, TAIT & COMPANY LTD.
1575 - 5TH. AVE.
PRINCE GEORGE, B.C. V2L 3L9

City of Prince George
HISTORY SHEET

SHEET NUMBER № 0278 **Roll Number** 006 519466

Legal: LOT'S 28 BLOCK D.L. 2611 PLAN 27420

Address: 3802 PINEWOOD AVE

Sanitary Connection: # SIZE 100 mm ø MATERIAL P.V.C. INV. 600.90 CONNECTED

Water Connection # SIZE 19 mm ø MATERIAL Cu. METER CONNECTED

Storm Connection: # SIZE MATERIAL CMP INV. CONNECTED

Cash Receipt No's: WATER SANITARY STORM

CURB FROM PROPERTY LINE 3.5 m @ PINEWOOD 5.0 m @ GOHEEN (ROLL) PAVEMENT WIDTH 10 m @ GOHEEN 13 m @ PINEWOOD

B.C. HYDRO U/G 2.9 m FROM PL. UNDERGROUND CONNECTION MID LOT

B.C. TELEPHONE U/G 2.9 m FROM PL. UNDERGROUND CONNECTION MID LOT

INLAND GAS 3 m FROM PL.

Information Sheets:

Comments:

THE INFORMATION CONTAINED HEREIN IS FOR INTERNAL USE ONLY. NOT TO BE RELIED UPON UNLESS CONFIRMED BY SITE INSPECTION AND/OR INVESTIGATION.
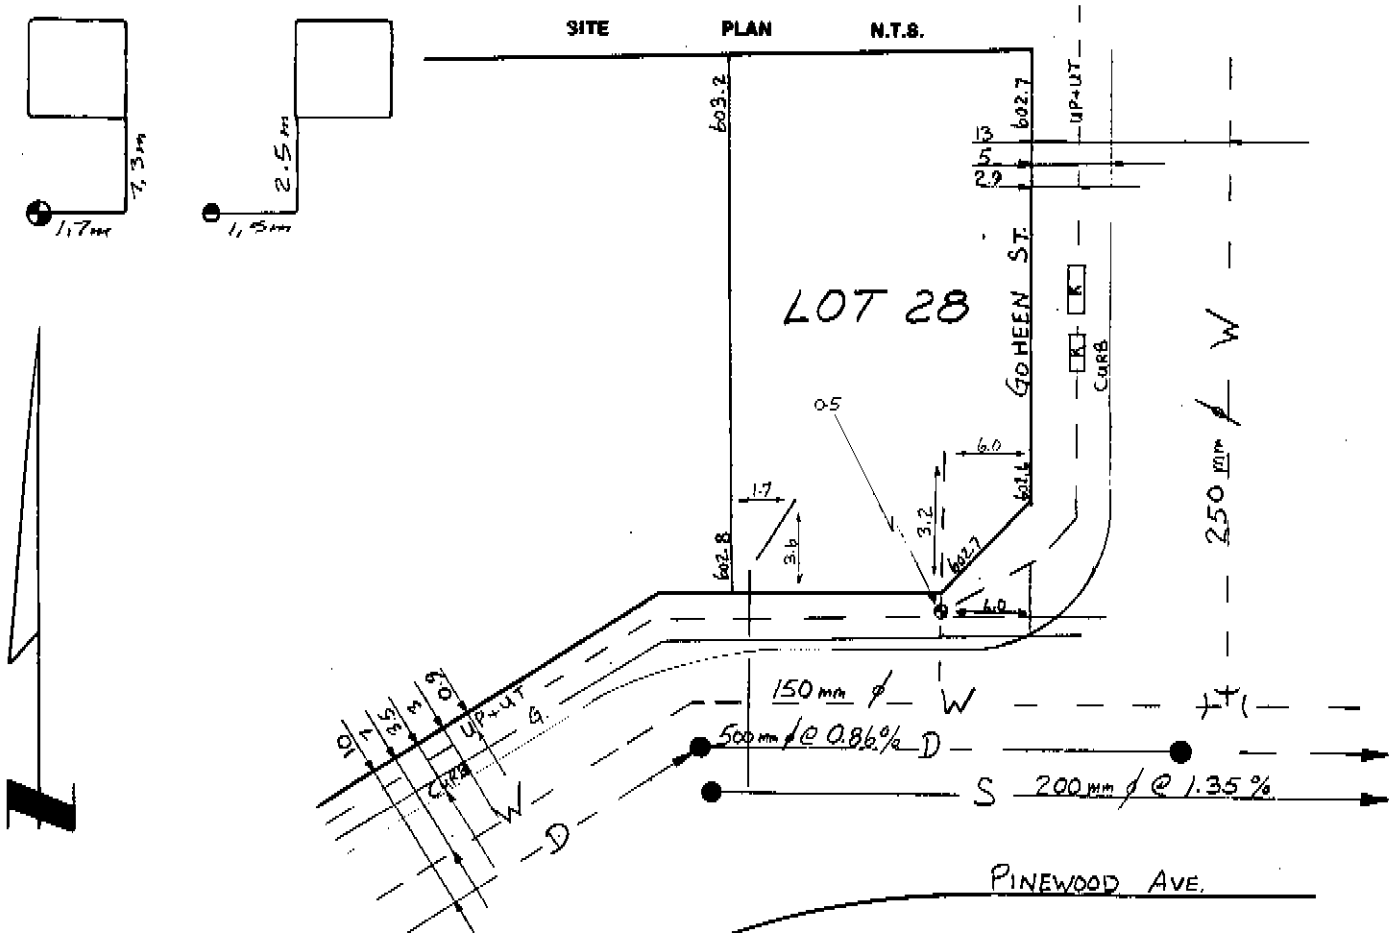
SITE PLAN N.T.S.