City of Prince George
HISTORY SHEET

006524991 S

SHEET NUMBER № 1970 **Roll Number**

Legal: LOT'S 11 BLOCK D.L. 751 PLAN 27361

Address: 9632 ANZAC CRESCENT

Sanitary Connection: # 15044 SIZE 150mm MATERIAL INV. CONNECTED

Water Connection # 15044 SIZE 150mm MATERIAL METER CONNECTED

Storm Connection: # 1581 SIZE 200mm MATERIAL INV. CONNECTED

Cash Receipt No's: WATER 063 SANITARY 064 STORM 06[illegible]

CURB FROM PROPERTY LINE PAVEMENT WIDTH

B.C. HYDRO UNDERGROUND CONNECTION

B.C. TELEPHONE UNDERGROUND CONNECTION

INLAND GAS

Information Sheets:

Comments: [illegible] contained herein is for [illegible] to be relied upon [illegible] and/or investigation.
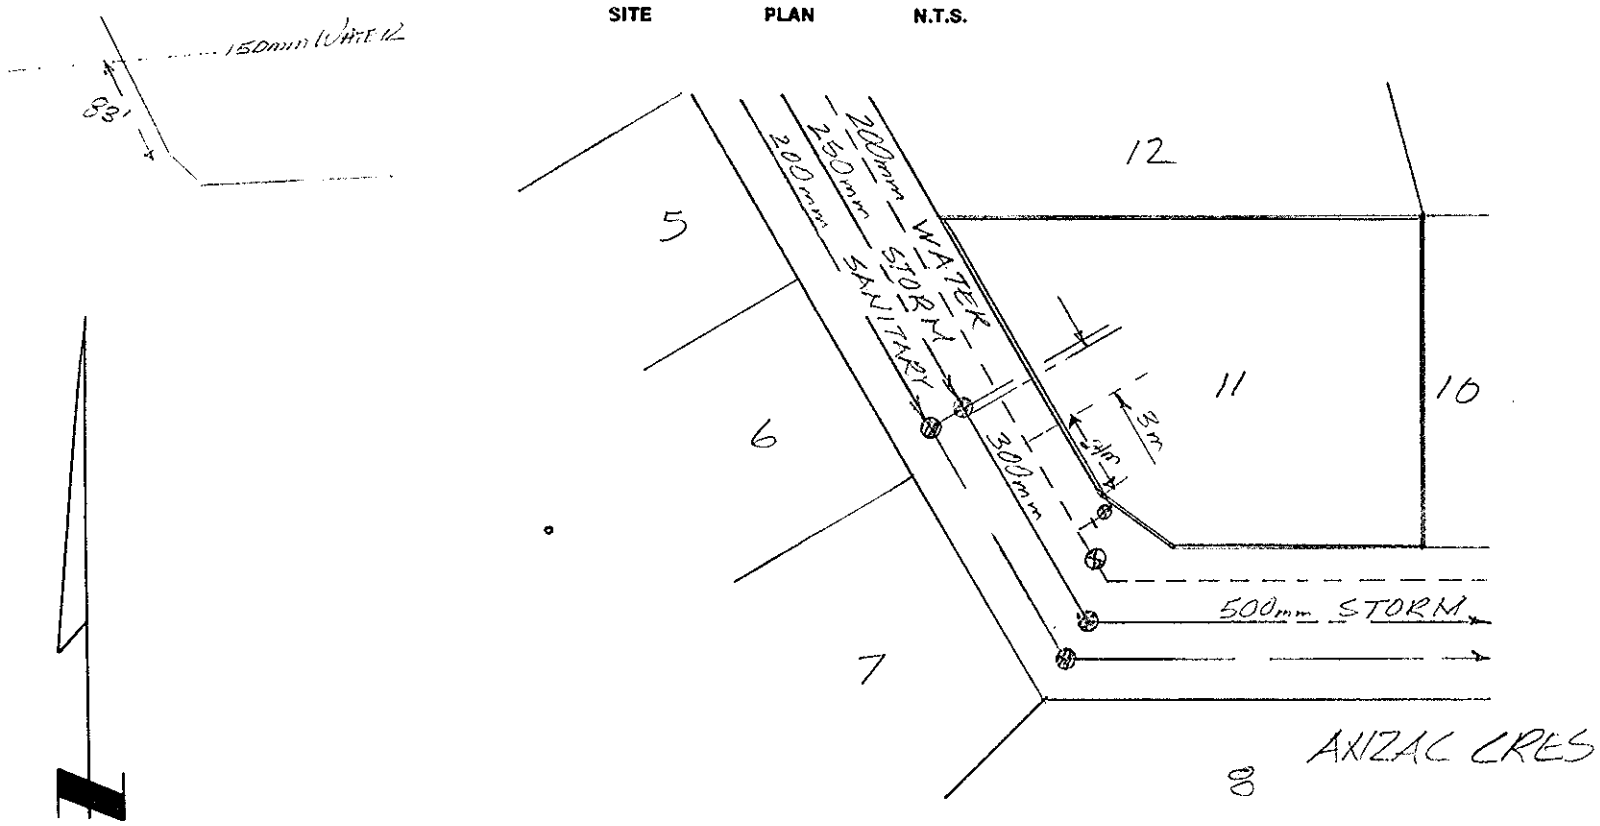
SITE PLAN N.T.S.