City of Prince George
HISTORY SHEET

FL

SHEET NUMBER

Roll Number 006:56/1414

Legal: LOT'S 7 BLOCK D.L. 2507 PLAN 20916

Address: 921 OCHAKWIN CRESCENT

Sanitary Connection: # 8803 SIZE 100mm MATERIAL AC INV. CONNECTED

Water Connection # 8803 SIZE 20mm MATERIAL Cu METER CONNECTED

Storm Connection: # SIZE MATERIAL INV. CONNECTED

Cash Receipt No's: WATER SANITARY STORM

CURB FROM PROPERTY LINE PAVEMENT WIDTH

B.C. HYDRO UNDERGROUND CONNECTION

B.C. TELEPHONE UNDERGROUND CONNECTION

INLAND GAS

Information Sheets:

Comments:
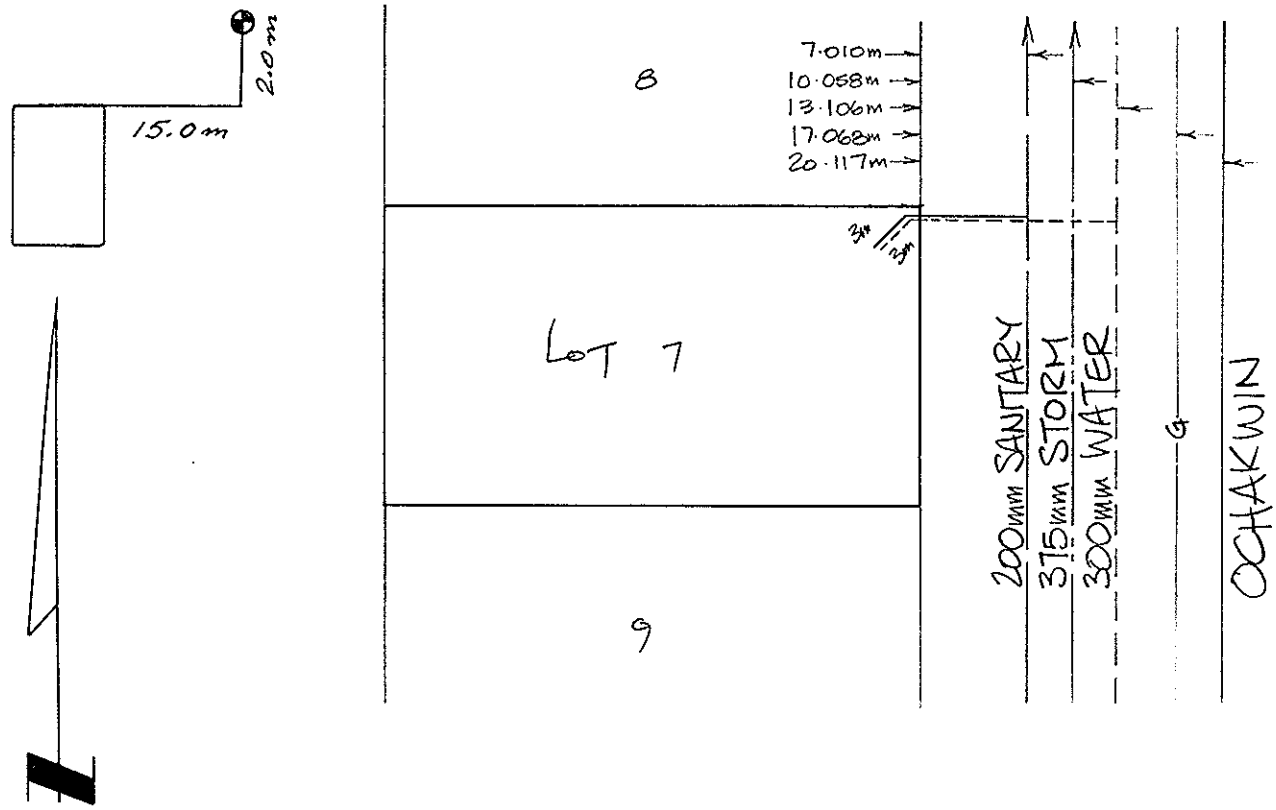
THE INFORMATION CONTAINED HEREIN IS FOR INTERNAL USE ONLY.
NOT TO BE RELIED UPON UNLESS CONFIRMED BY SITE INSPECTION AND/OR INVESTIGATION