City of Prince George
HISTORY SHEET

306587640

SHEET NUMBER **3903** **Roll Number**

Legal: LOT'S 2 BLOCK D.L. 4040 PLAN 27198

Address: 3458 BELLAMY ROAD.

Sanitary Connection: # SIZE 4" MATERIAL PVC INV. 2114.29 CONNECTED

Water Connection # SIZE 3/4" MATERIAL COPPER METER CONNECTED

Storm Connection: # SIZE MATERIAL INV. CONNECTED

Cash Receipt No's: WATER SANITARY STORM

CURB FROM PROPERTY LINE 16' PAVEMENT WIDTH 34'

B.C. HYDRO O/S 9.0' FROM PL UNDERGROUND CONNECTION U/G - MID LOT

B.C. TELEPHONE O/S 10.0' FROM PL UNDERGROUND CONNECTION U/G - MID LOT

INLAND GAS

Information Sheets:

Comments: BENCH MARK - HYDRANT DIRECTION ARROW @ NW CORNER BELLAMY RD & CLEARWOOD CRES. ELEVATION = 2123.85
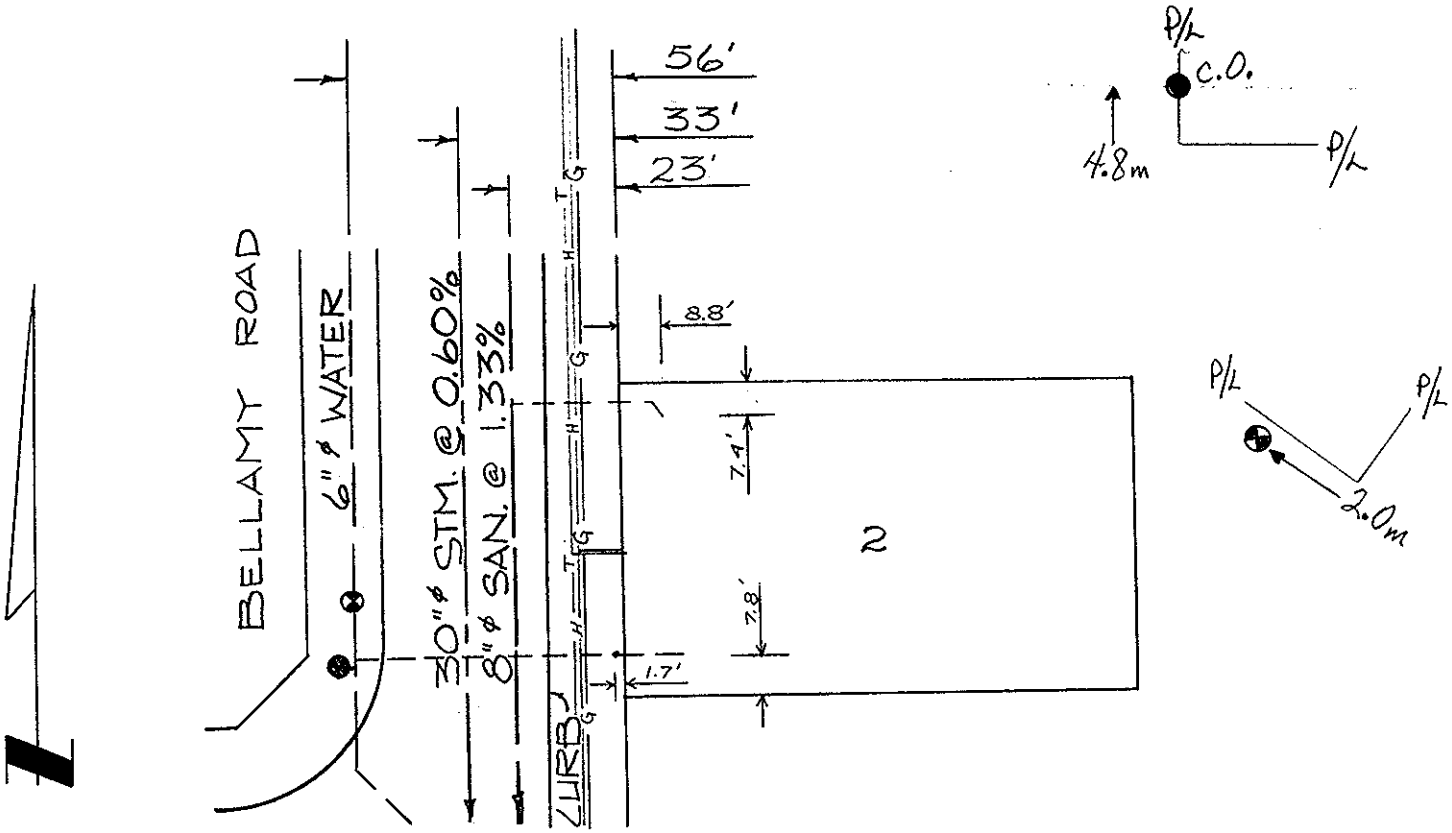
SITE PLAN N.T.S.