City of Prince George
HISTORY SHEET

3066 + 344

SHEET NUMBER **Roll Number**

Legal: LOT'S 56 BLOCK D.L. 936 PLAN 10868

Address: 1669 LYON STREET

Sanitary Connection: # 15224 SIZE 100mm MATERIAL INV. CONNECTED

Water Connection # 15224 SIZE 20mm MATERIAL METER CONNECTED

Storm Connection: # 1411 SIZE 150mm MATERIAL INV. CONNECTED

Cash Receipt No's: WATER 376 SANITARY 375 STORM 377

CURB FROM PROPERTY LINE PAVEMENT WIDTH

B.C. HYDRO UNDERGROUND CONNECTION

B.C. TELEPHONE UNDERGROUND CONNECTION

INLAND GAS

Information Sheets:

Comments:
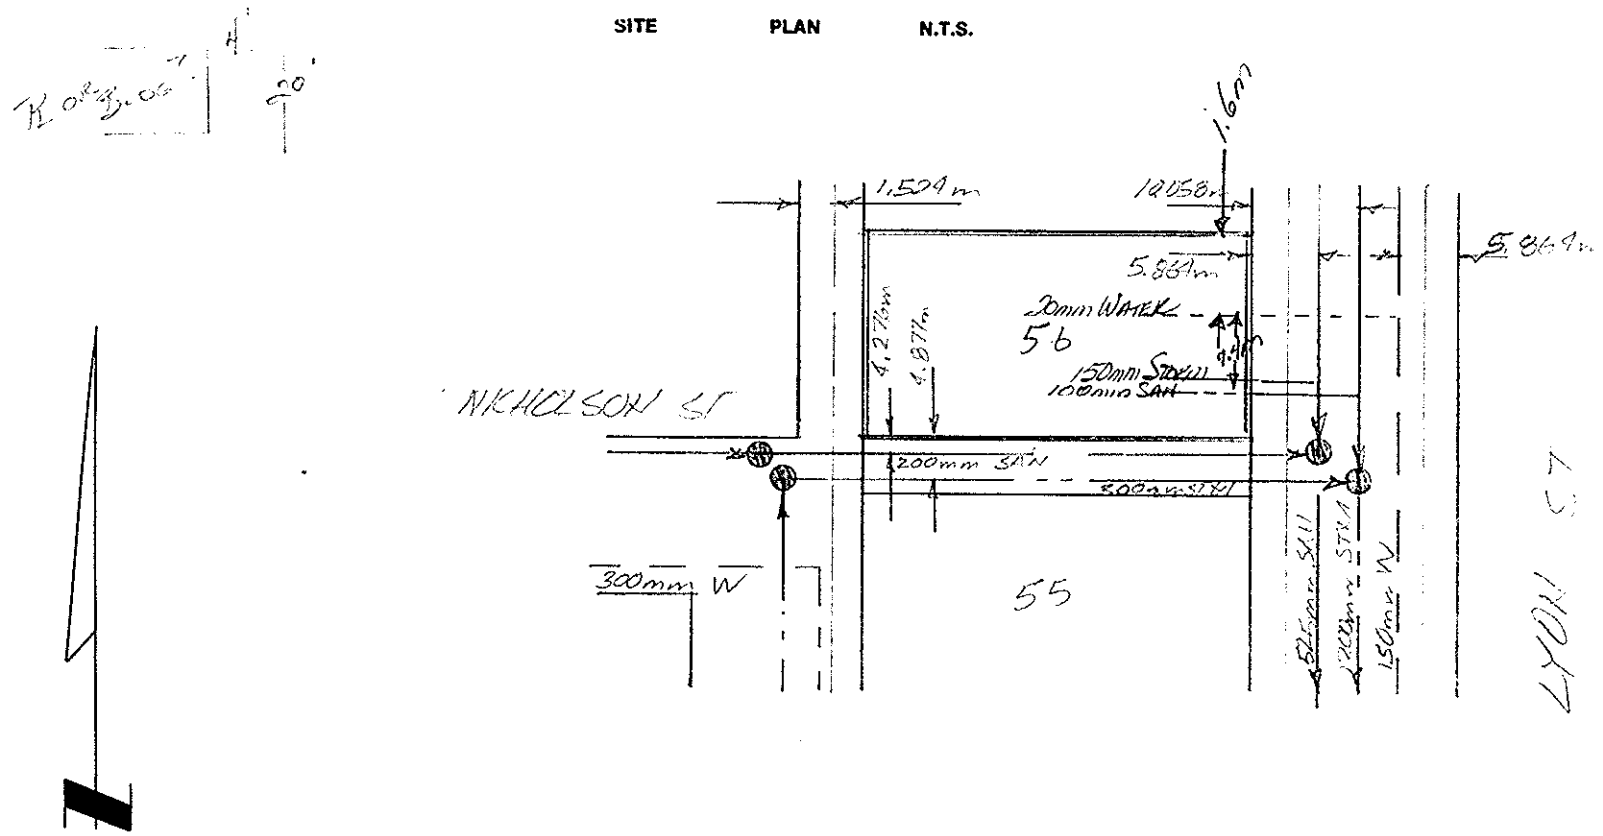
SITE PLAN N.T.S.