City of Prince George
HISTORY SHEET

SHEET NUMBER **3112** **Roll Number** 00669400

Legal: LOT'S 12 BLOCK D.L. 2608 PLAN 26049

Address: 1076 HERITAGE CR.

Sanitary Connection: # SIZE 100 mm ϕ MATERIAL P.V.C. (WHITE) INV. 603.33 CONNECTED

Water Connection # SIZE 19mm ϕ MATERIAL COPPER METER CONNECTED

Storm Connection: # N/A SIZE MATERIAL INV. CONNECTED

Cash Receipt No's: WATER SANITARY STORM

CURB FROM PROPERTY LINE 5.0 M PAVEMENT WIDTH

B.C. HYDRO AS SHOWN UNDERGROUND CONNECTION U/G

B.C. TELEPHONE AS SHOWN UNDERGROUND CONNECTION U/G

INLAND GAS AS SHOWN

Information Sheets:

Comments: CITY OF P.G. - B.M. #975 - H.S. - S.E. COR. TABOR BLVD & McDERMID DR. ELEV. 608.403
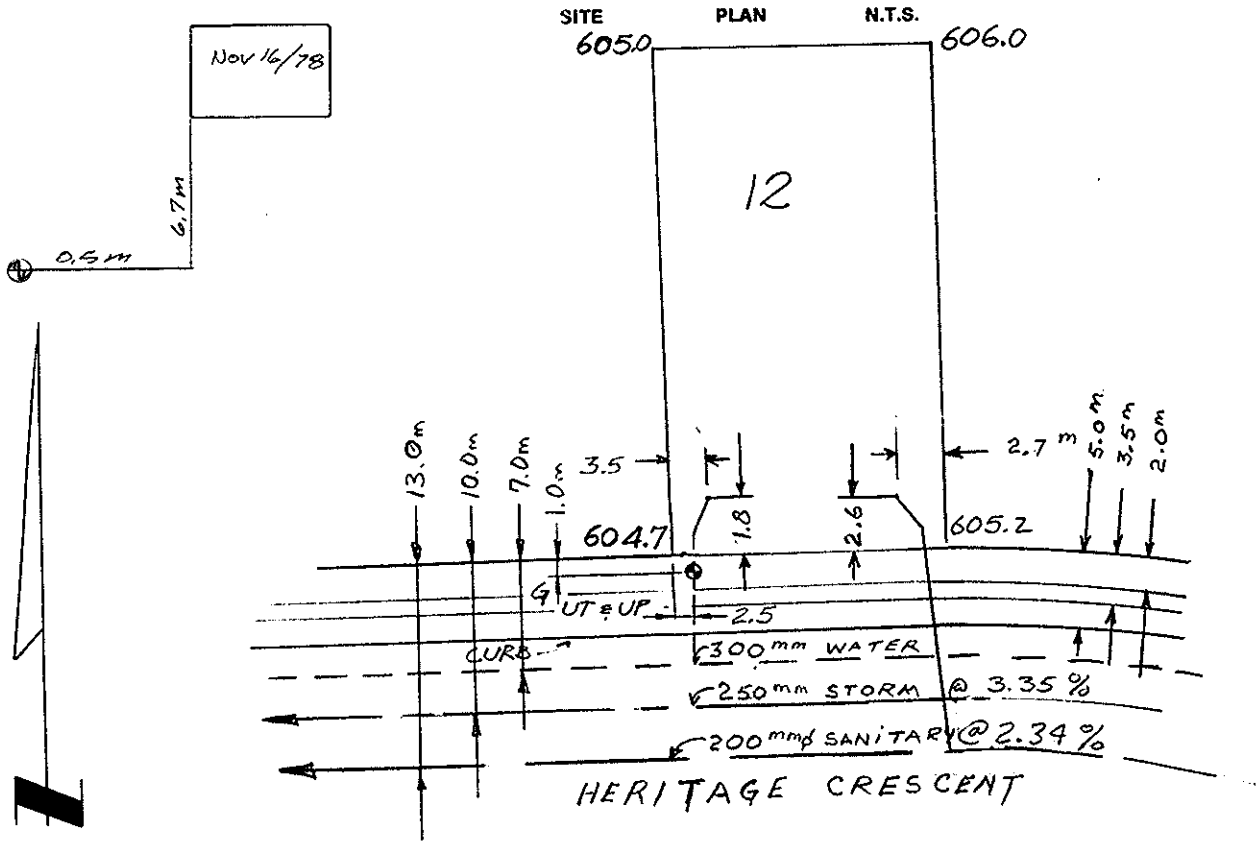
SITE PLAN N.T.S.