City of Prince George
HISTORY SHEET

SHEET NUMBER № 0502 **Roll Number** 006 006 936

Legal: LOT'S 2 BLOCK D.L. 937 PLAN 9107

Address: 172 DOUGLAS ST.

Sanitary Connection: # 702 SIZE MATERIAL INV. CONNECTED

Water Connection # 2002 SIZE 3/4" MATERIAL COPPER METER CONNECTED

Storm Connection: # SIZE MATERIAL INV. CONNECTED

Cash Receipt No's: WATER SANITARY STORM

CURB FROM PROPERTY LINE PAVEMENT WIDTH

B.C. HYDRO UNDERGROUND CONNECTION

B.C. TELEPHONE UNDERGROUND CONNECTION

INLAND GAS

Information Sheets:

Comments: SANITARY SEWER AND WATER SERVICE CONNECTIONS ARE IN A COMMON TRENCH AT MID-POINT OF EACH LOT FRONTAGE

REF. DWG 649

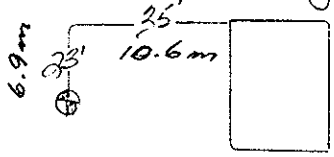
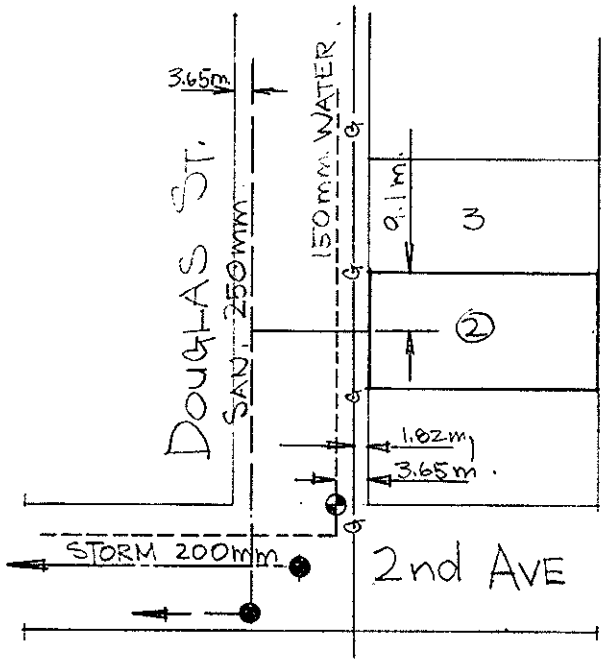
SITE PLAN N.T.S.