City of Prince George
HISTORY SHEET

SHEET NUMBER **Roll Number** 0067129.67

Legal: LOT'S 133 BLOCK D.L. 2611 PLAN 21607

Address: 4154 GUEST CRESCENT

Sanitary Connection: # 9332 SIZE 4" MATERIAL A.C. INV. 68.34 CONNECTED

Water Connection # 9332 SIZE 3/4" MATERIAL Copper METER CONNECTED

Storm Connection: # SIZE MATERIAL INV. CONNECTED

Cash Receipt No's: WATER SANITARY STORM

CURB FROM PROPERTY LINE 4.877 m PAVEMENT WIDTH 10.363 m

B.C. HYDRO U/G UNDERGROUND CONNECTION

B.C. TELEPHONE U/G UNDERGROUND CONNECTION

INLAND GAS AS SHOWN

Information Sheets:

Comments: WATER and SANITARY CONN IS CENTRED ON LOT WITH THAW WIRE;

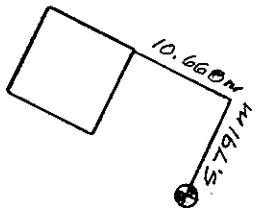
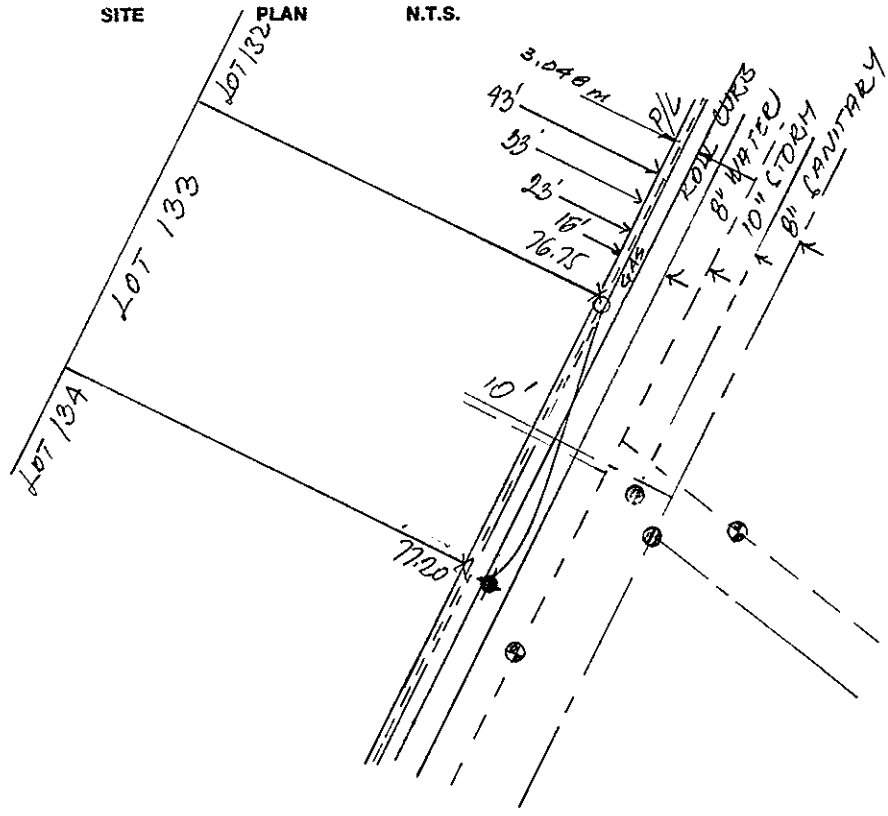
SITE PLAN N.T.S.