366 006744061
382 087
391 117
404 014043 125 505

City of Prince George
HISTORY SHEET

SHEET NUMBER № 4961 **Roll Number**

Legal: LOT'S 19-27 BLOCK 45 D.L. 629 PLAN 702

Address: 2955 BOEING RD.

Sanitary Connection: # 10135 SIZE MATERIAL INV. CONNECTED

Water Connection # SIZE MATERIAL METER CONNECTED

Storm Connection: # SIZE MATERIAL INV. CONNECTED

Cash Receipt No's: WATER SANITARY 970 STORM

CURB FROM PROPERTY LINE PAVEMENT WIDTH

B.C. HYDRO UNDERGROUND CONNECTION

B.C. TELEPHONE UNDERGROUND CONNECTION

INLAND GAS

Information Sheets:
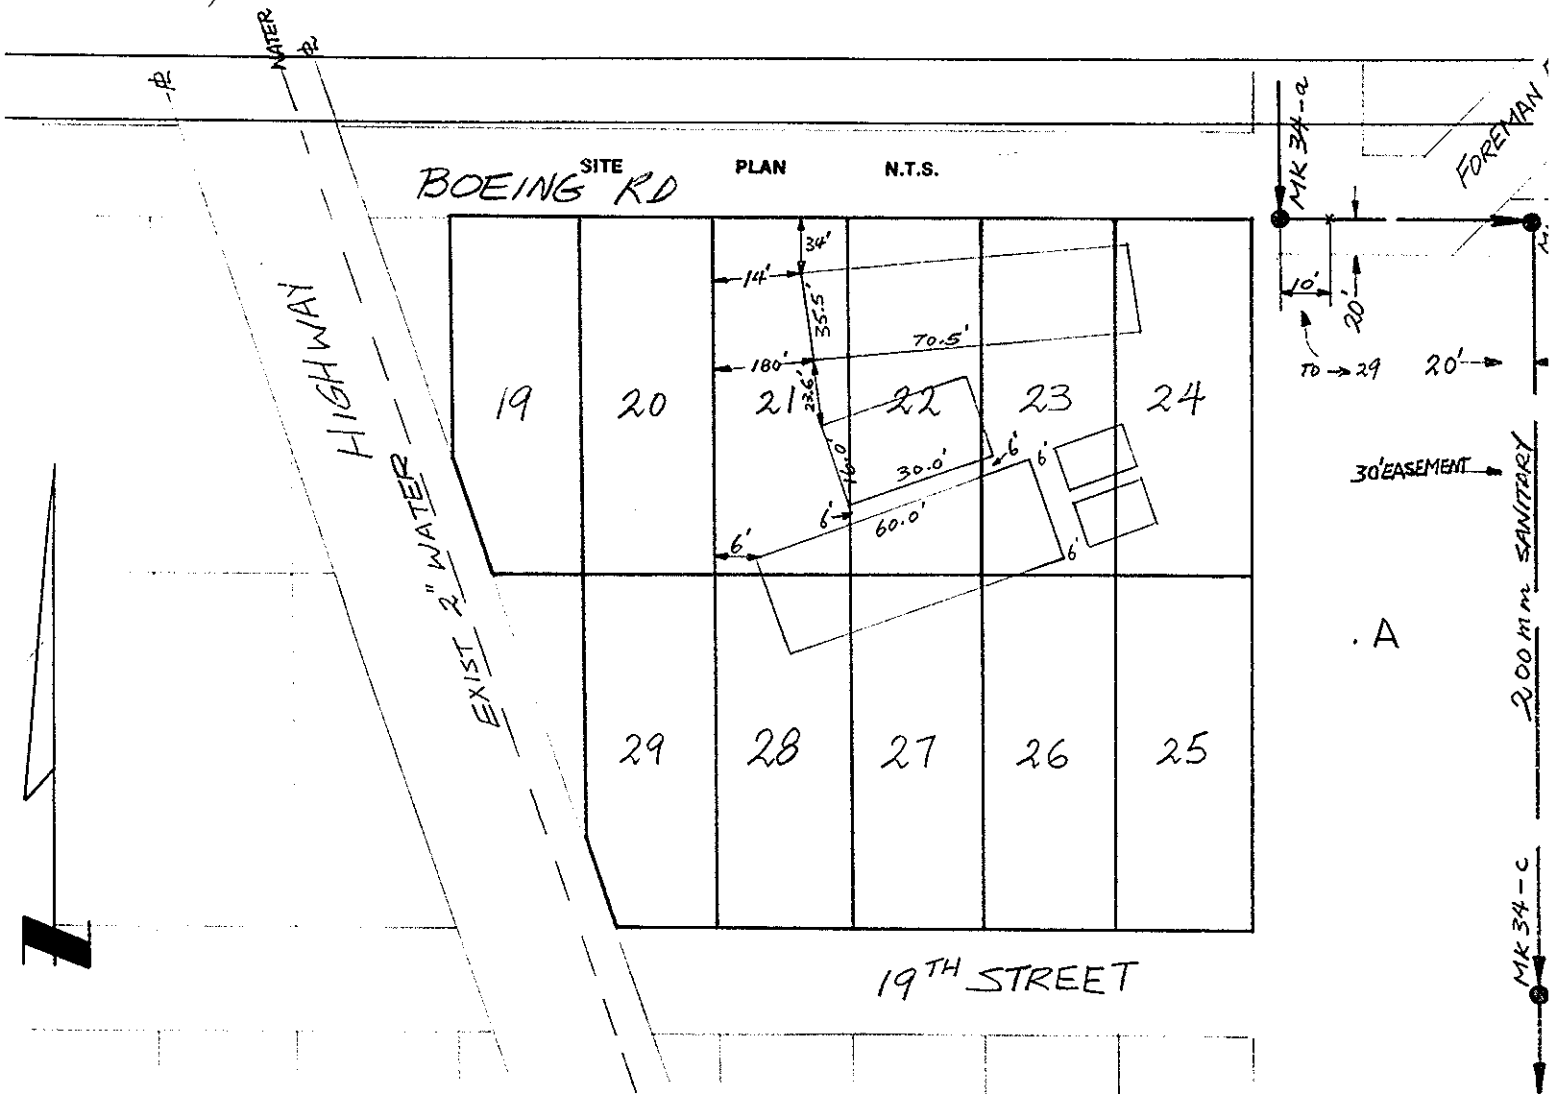
Comments: 4/0 - 077 ASSESS - PINEDALE AUTO WRECKERS