City of Prince George

# History Sheet

| | |
|---|---|
| PID: | 006750338 |
| | 006750354 |
| | 006750419 |
| | 006750443 |
| | 006010237 |
| | 006010245 |
| SD/MU: | |
| WO: | |

Civic Address: 375, 385, 395 Victoria St
1550 4th Ave

Legal Description: Lot: 13 -18 Block: 130 District Lot: 343 Plan: 1268

| Service Type | Diameter (mm) | Material | Invert Elev at main (m) | Invert Elev at property line (m) | Invert Elev at service end (m) | Distance into property (m) | Installation Date |
|---|---|---|---|---|---|---|---|
| Sanitary (S1) | 100mm | AC | - | - | - | - | January 1959 |
| Sanitary (S2) | 100mm | AC | - | - | - | - | January 1959 |
| Sanitary (S3) | 100mm | AC | - | - | - | - | January 1959 |
| Sanitary (S4) | 100mm | AC | - | - | - | - | January 1959 |
| Water | 20mm | Copper | - | - | - | - | January 1957 |
| Storm | 200mm | C.I.P. | - | - | - | - | January 1973 |

| Service Connection Location | | | | Sanitary (m) | Storm (m) |
|---|---|---|---|---|---|
| Distance from downstream San MH | - | towards upstream San MH | - | - | |
| 200mm Storm main connected to Stm 2244 | | | | | |

| Power | Size | Communications | Size | Cable | Size | Gas | Size |
|---|---|---|---|---|---|---|---|
| BC Hydro | - | Telus | - | Shaw | - | FortisBC | - |
| Overhead Service | | Overhead Service | | Overhead Service | | | |

| | | |
|---|---|---|
| Installed by: | Survey Date: | - |
| Comments: | | |
| | | |
| | | |

**NOT TO SCALE The information contained herein is for internal use only.**
**Not to be relied on unless confirmed by site inspection and/or investigation.**

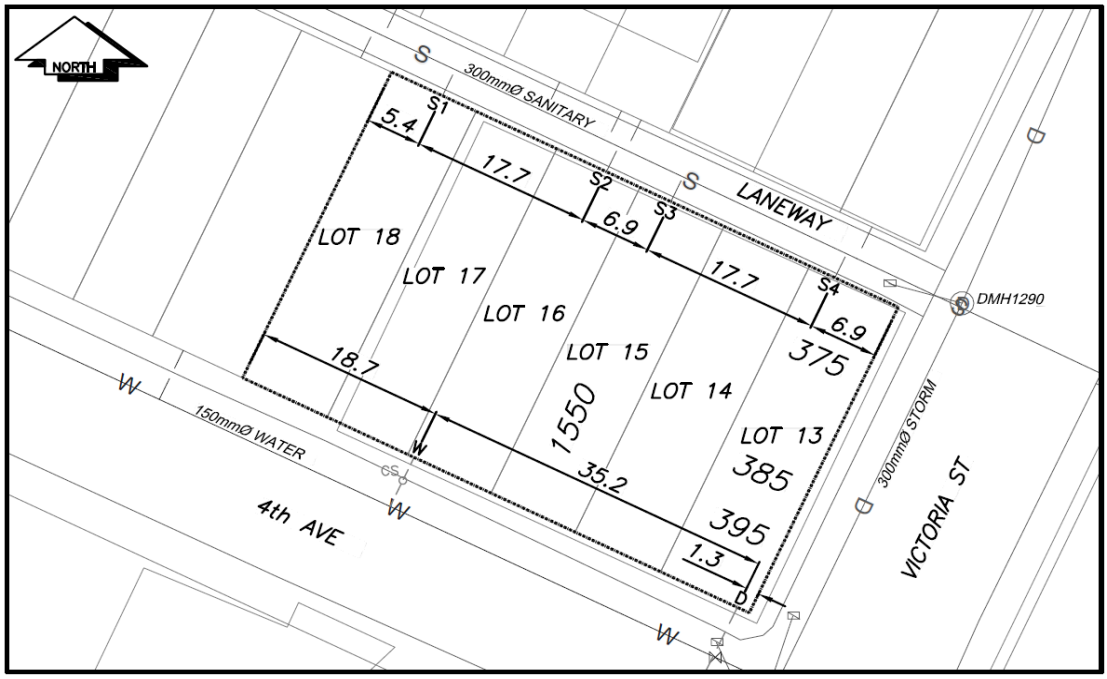


LEGEND:

| | | |
|---|---|---|
| CS CURB STOP | WATER SERVICE | STORM SERVICE |
| CO CLEAN OUT | SANITARY SERVICE | GAS |
| WATER VALVE | FIRE HYDRANT | ENCUMBERANCE |

**NOT TO SCALE**