City of Prince George
HISTORY SHEET

SHEET NUMBER № 4512 **Roll Number** 00675340.0

Legal: LOT'S 12 BLOCK D.L. 4047 PLAN 21039

Address:

Sanitary Connection: # SIZE 100ϕ MATERIAL PVC INV. 730.22 CONNECTED

Water Connection # SIZE 20ϕ MATERIAL Copper METER No CONNECTED

Storm Connection: # SIZE 100ϕ MATERIAL PVC INV. 730.51 CONNECTED

Cash Receipt No's: WATER SANITARY STORM

CURB FROM PROPERTY LINE 5.0m (ROLL CURB) PAVEMENT WIDTH 10.0m

B.C. HYDRO o/s 2.7 FROM PL UNDERGROUND CONNECTION U/G MID LOT

B.C. TELEPHONE o/s 3.0 FROM PL UNDERGROUND CONNECTION U/G MID LOT

INLAND GAS

Information Sheets:

Comments: BENCH MARK - HYDRANT SPINDLE EAST SIDE OF ROAD IN FRONT OF LOT #9 - 733.816
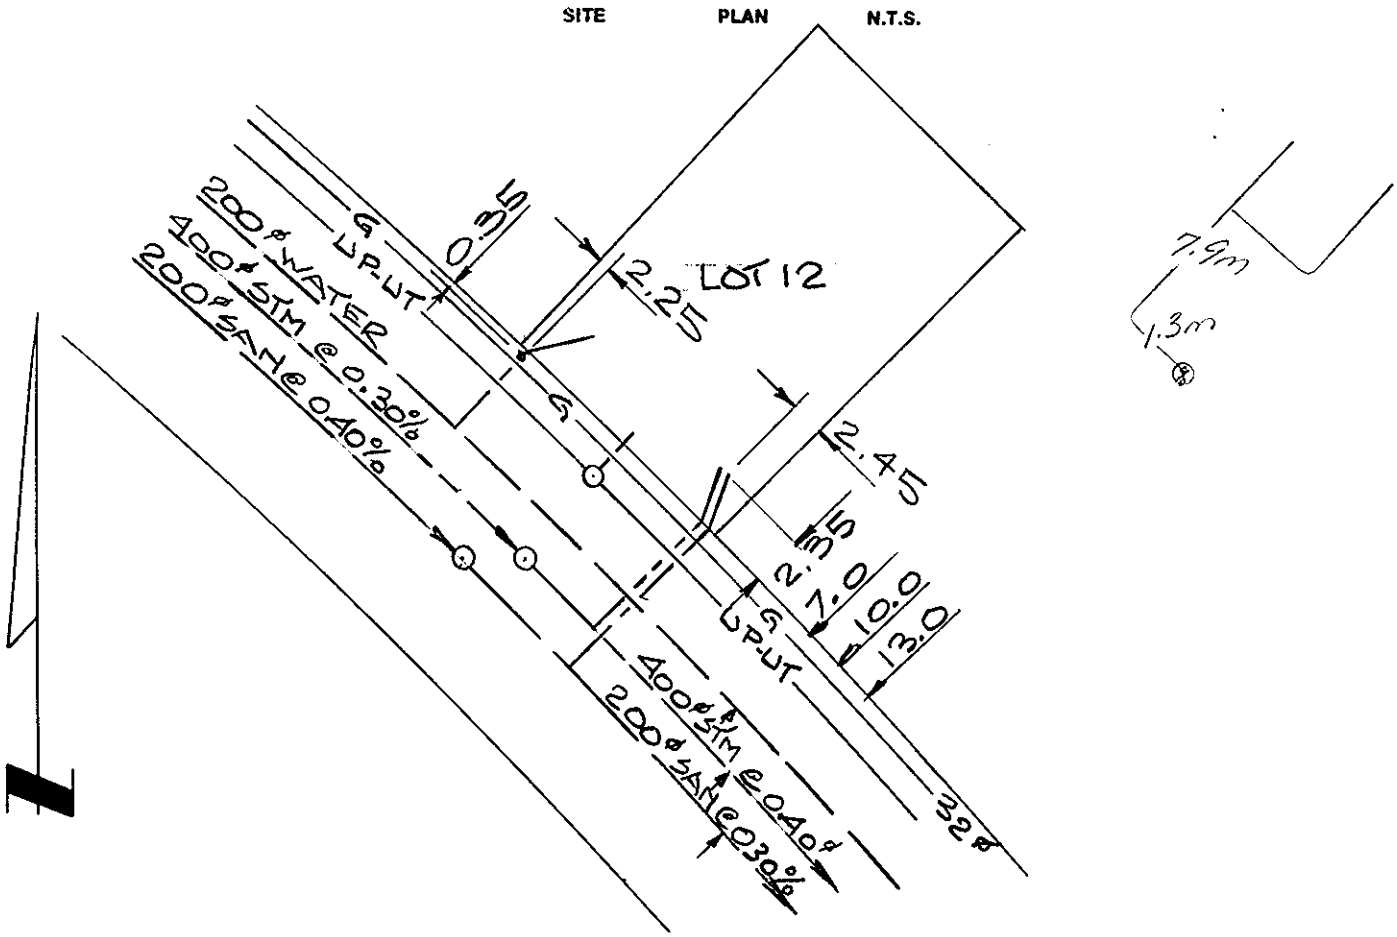
SITE PLAN N.T.S.