DS

City of Prince George
HISTORY SHEET

SHEET NUMBER № 4504 **Roll Number** 0067535 66

Legal: LOT'S 4 BLOCK D.L. 4047 PLAN 27039

Address: 6578 DRIFTWOOD RD.

Sanitary Connection: # SIZE 100 ϕ MATERIAL PVC INV. 731.22 CONNECTED

Water Connection # SIZE 20 ϕ MATERIAL Copper METER CONNECTED

Storm Connection: # SIZE 100 ϕ MATERIAL PVC INV. 731.30 CONNECTED

Cash Receipt No's: WATER SANITARY STORM

CURB FROM PROPERTY LINE 5.0 m (ROLL CURB) PAVEMENT WIDTH 10.0 m

B.C. HYDRO %s 2.7 FROM P UNDERGROUND CONNECTION U/G - MIDLOT

B.C. TELEPHONE %s 3.0 FROM P UNDERGROUND CONNECTION U/G - MIDLOT

INLAND GAS

Information Sheets:

Comments: BENCH MARK - HYDRANT SPINDLE EAST SIDE OF ROAD IN FRONT OF LOT # 9 - 733.816
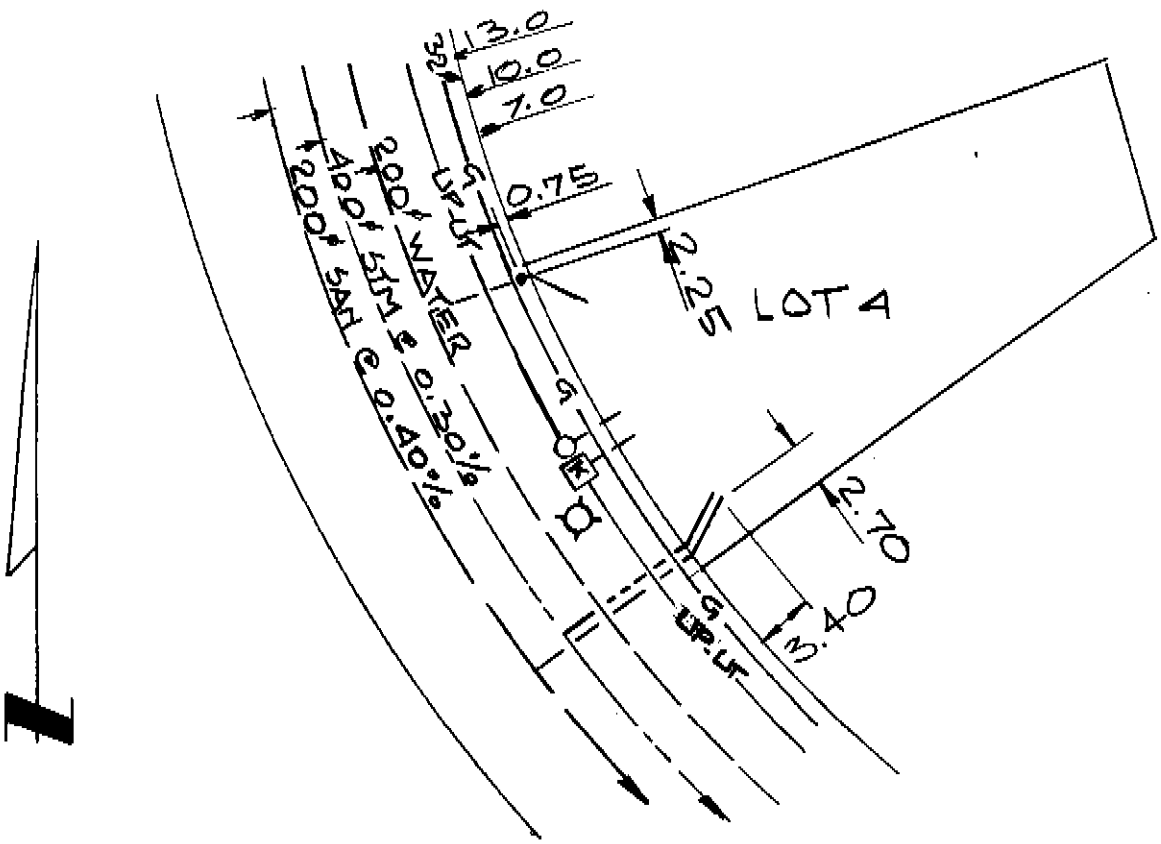
SITE PLAN N.T.S.