City of Prince George
HISTORY SHEET

SHEET NUMBER № 0795 **Roll Number** 006829023

Legal: LOT'S 38 BLOCK D.L. 754 PLAN 36821

Address: 7548 ST MARY CRES

Sanitary Connection: # SIZE 4" ϕ MATERIAL P.V.C. INV. CONNECTED

Water Connection # SIZE 3/4" ϕ MATERIAL Cu. METER CONNECTED

Storm Connection: # SIZE 4" ϕ MATERIAL P.V.C. INV. CONNECTED

Cash Receipt No's: WATER SANITARY STORM

CURB FROM PROPERTY LINE 16' (ROLL CURB) PAVEMENT WIDTH 34'

B.C. HYDRO UNDERGROUND CONNECTION U/G - MID LOT

B.C. TELEPHONE UNDERGROUND CONNECTION U/G - MID LOT

INLAND GAS

Information Sheets:

Comments: H.L.D. B.M. ELEVATION 2096.36
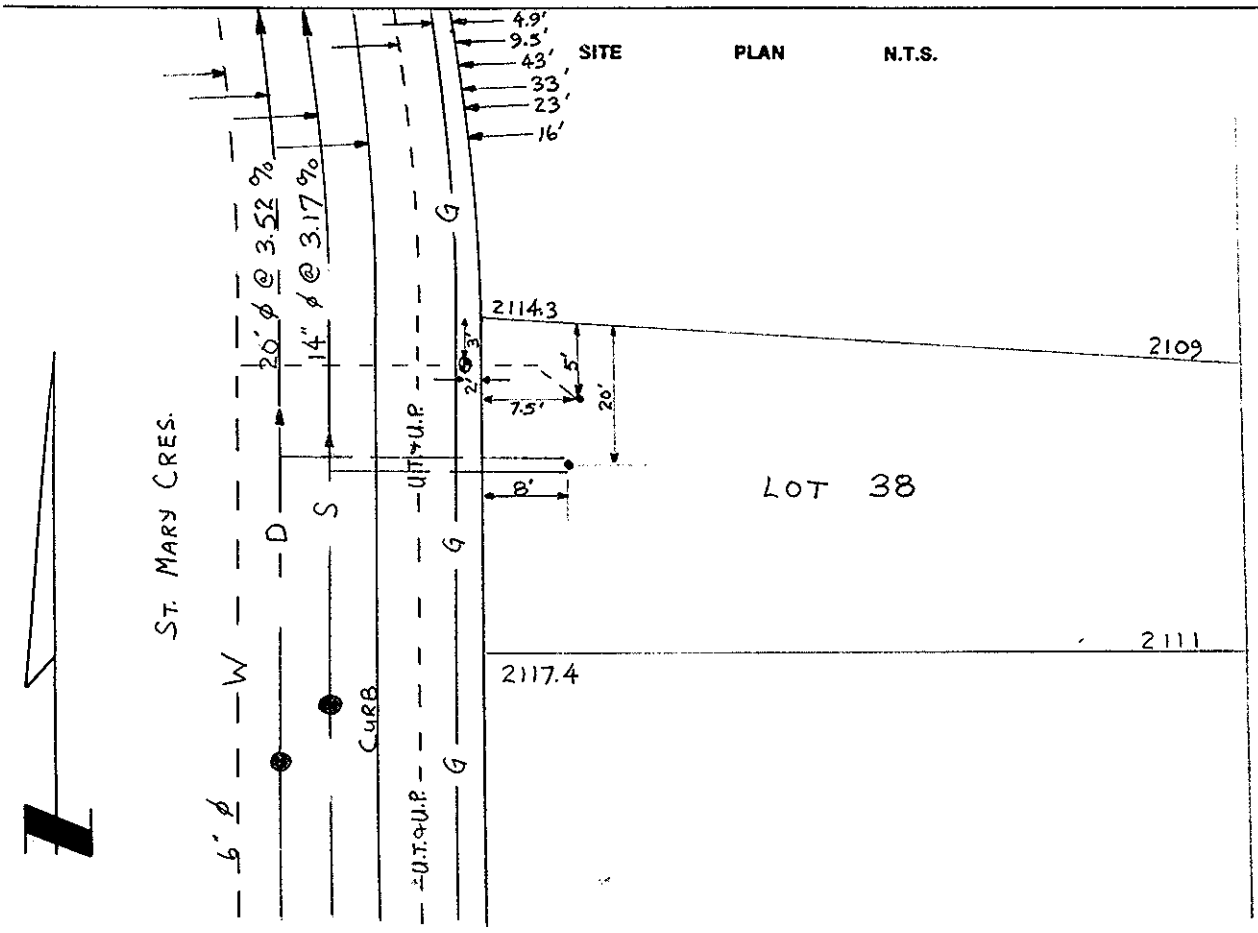
HYD. ARROW INT. ST. PATRICK & ST. LAWRENCE