City of Prince George
HISTORY SHEET

SHEET NUMBER 3390 **Roll Number** 006847293

Legal: LOT'S 3 BLOCK D.L. 2611 PLAN 25193

Address: 4182 JACKSON CRES.

Sanitary Connection: # 12303 SIZE 100 MM MATERIAL AC INV. 1976.25 CONNECTED

Water Connection # 12303 SIZE 19 MM MATERIAL PVC METER CONNECTED

Storm Connection: # SIZE MATERIAL INV. CONNECTED

Cash Receipt No's: WATER SANITARY STORM

CURB FROM PROPERTY LINE 4.9M & VARIES PAVEMENT WIDTH 10.4M

B.C. HYDRO UP-250 UNDERGROUND CONNECTION

B.C. TELEPHONE UT-375 UNDERGROUND CONNECTION

INLAND GAS AS SHOWN

Information Sheets:

Comments: SEE ENG. DWG. 2841 & WB # 375 & # 366
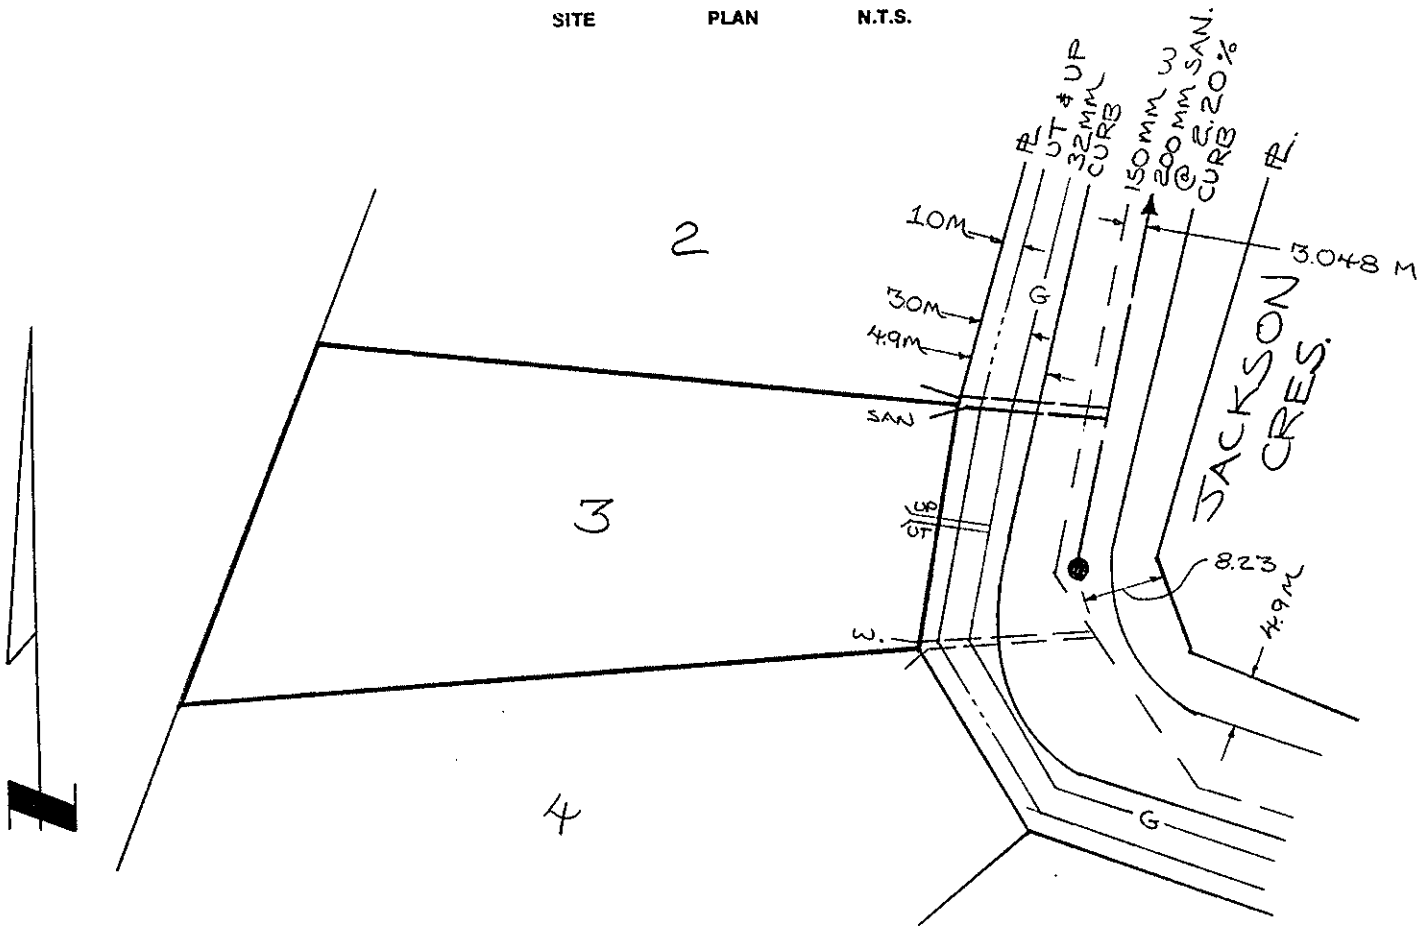
SITE PLAN N.T.S.