City of Prince George
HISTORY SHEET

0068588 05

SHEET NUMBER 6053 Roll Number

Legal: LOT'S 11 BLOCK D.L. 4047 PLAN 16105

Address: 3689 HAZEL DRIVE Birchwood Sub.

Sanitary Connection: # 12604 SIZE 4" MATERIAL INV. 734.635 CONNECTED

Water Connection # SIZE 3/4" MATERIAL Copper METER CONNECTED

Storm Connection: # SIZE MATERIAL INV. CONNECTED

Cash Receipt No's: WATER SANITARY 2462 STORM

CURB FROM PROPERTY LINE PAVEMENT WIDTH

B.C. HYDRO OH UNDERGROUND CONNECTION

B.C. TELEPHONE OH. UNDERGROUND CONNECTION

INLAND GAS AS SHOWN.

Information Sheets:

Comments:

OWNER: STERN Maurice Kenneth & Elaine 1-7-75
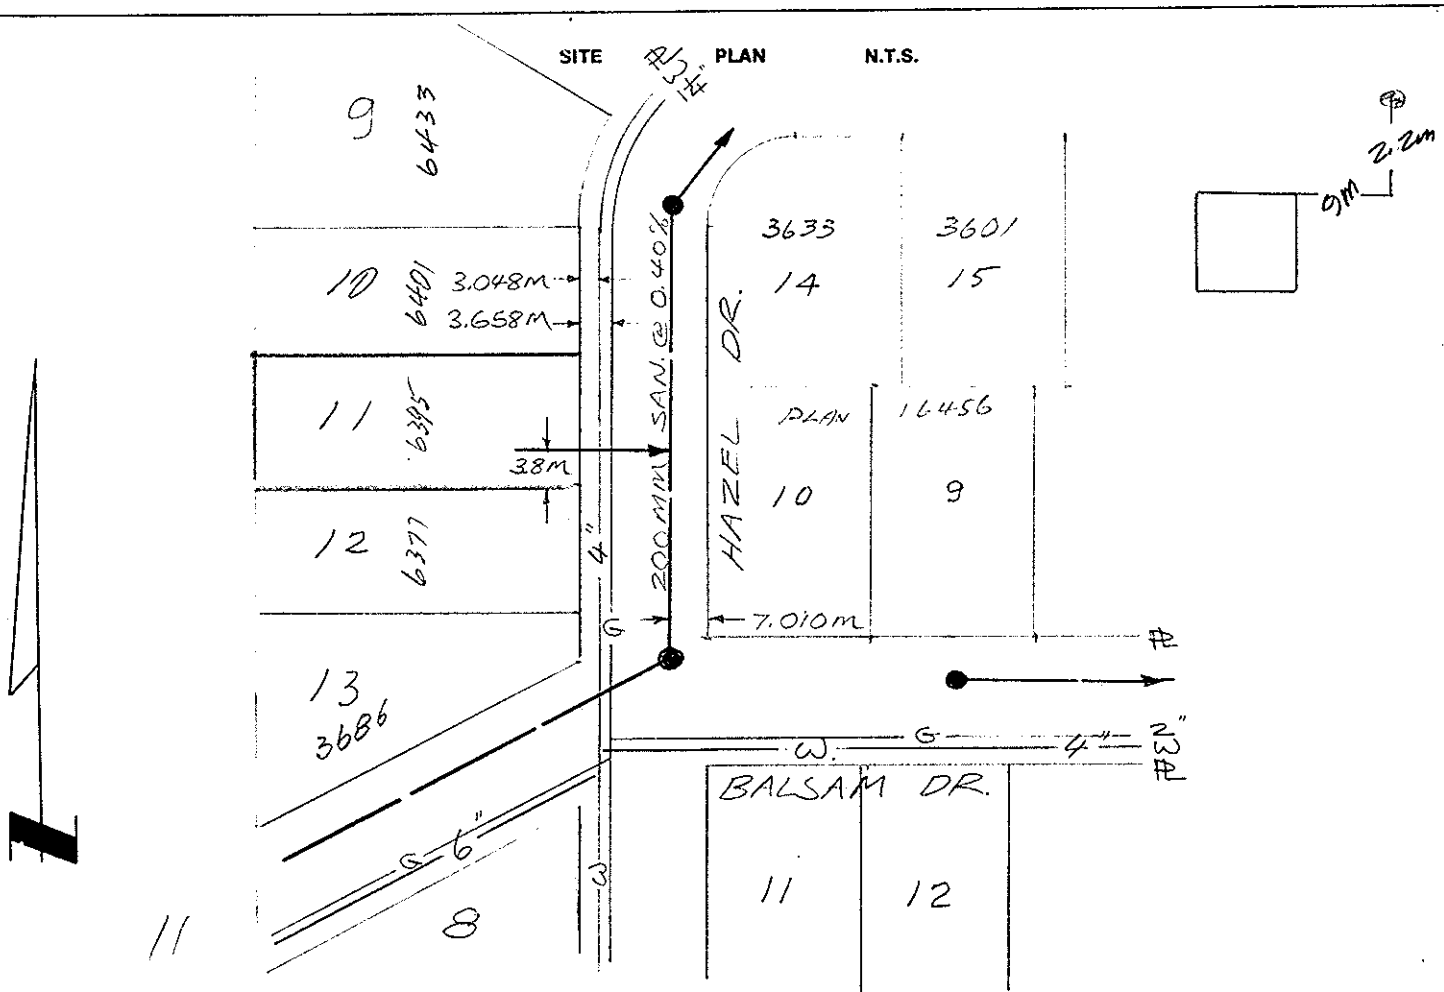
SITE PLAN N.T.S.